


CERTIFIED RECORD OF LAND CORNER MONUMENTATION

History of original corner establishment:

Corner established in 1921 by Collier.

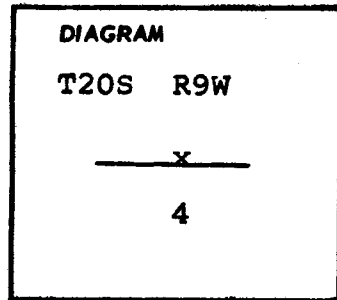

Description of corner evidence found:

Found cement filled pipe set in 1921 by G.L.O. from which
40" fir brs. S2W 12.4 ft
evidence of face

Description of monument and accessories I established to perpetuate the original location of this corner

Set 2"x30" iron pipe with brass cap mkd

T20S R9W



1970

650

Set pipe alongside corner.

Set a fence post with signs ± 5 ft south facing east

#18-120-9
#8-19-9

Office of SURVEYOR County of DOUGLAS
State of ORE, I hereby certify that the within instrument was filed in this office
for record on the 1ST day of MAY, 1970, at 9 o'clock Am (signed)

James W. Patten
(COUNTY OFFICIAL)

by _____ (DEPUTY)

FILED
RECEIVED

REGISTERED
OREGON
LAND SURVEYOR

MAY 11 1970

Tom O. McCullough
JULY 10, 1964
TOM O. McCULLOUGH
650

COUNTY SURVEYOR
DOUGLAS COUNTY, ORE.
Form R6-7100-57 (9/66)