


CERTIFIED RECORD OF LAND CORNER MONUMENTATION

History of original corner establishment:

Corner established in 1878 by James Tolman.

Re-established by Roy Gibson in June, 1957
by double proportional measurements

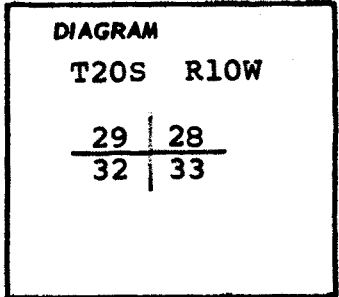

Description of corner evidence found:

Found an X 8" high on east face of 4' sandstone outchop
scribed by Gibson in 1957 from which - See Rem. #7

44" fir brs. N45½W 35.8 ft
visible scribing - with tag

14" maple brs. N88E 48.6 ft - scribing visible
with tag

6" fir brs. S21W 4.2 ft
face healed - with tag - windthrown

(Above BTs established by Gibson in 1957)

Description of monument and accessories established to perpetuate the
original location of this corner

Set 2"x30" iron pipe with brass cap mkd

T20S	R10W	
29	28	
32	33	
1970		
650		from which

WC WC 4.4 ft east of true corner

11" fir brs. N32W 23.2 ft
scribed S29 BT

11" fir brs. S89½W 16.1 ft
scribed S32 BT - with tag

Set 2 fence posts with signs + 5 ft west facing south
+ 5 ft south facing west

#39

Office of SURVEYOR County of DOUGLAS
 State of ORE, I hereby certify that the within instrument was filed in this office
 for record on the 15 day of MAY, 1970, at 9 o'clock A.M., (signed)
[Signature] by [Signature] (DEPUTY)
 (COUNTY OFFICIAL)

FILED
RECEIVED

MAY 11 1970

COUNTY SURVEYOR
DOUGLAS COUNTY, ORE.

Form R6-7100-57 (9/66)

REGISTERED OREGON LAND SURVEYOR

[Signature]
 JULY 10, 1964
 TOM O. McCULLOUGH
 650

C. S. File No. 55/148-6