


CERTIFIED RECORD OF LAND CORNER MONUMENTATION

History of original corner establishment:

Corner established in 1878 by James Tolman.

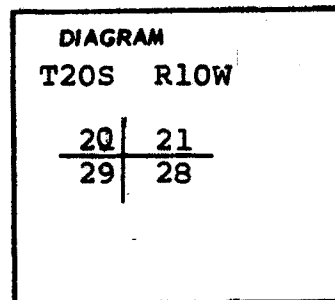

Description of corner evidence found:


Found 3/4" iron pipe set by Gibson in 1957 - ^{See Rec. #6} from which

48" fir brs. N35E 46.4 ft
scribing visible - with tag - has been chopped out (orig)

20" alder brs. S36W 35.4 ft
with tag - scribing visible - has been chopped out

Description of monument and accessories established to perpetuate the original location of this corner

Set 2"x30" iron pipe with brass cap mkd

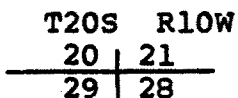

1970
650 from which

12" maple brs. N68W 26.2 ft
scribed S20 BT - wt tag

12" hemlock brs. S1E 54.5 ft
scribed S28 BT - with tag

Set 2 fence posts with signs + 5 ft west facing south
± 5 ft south facing west.

40

Office of SURVEYOR County of DOUGLAS
State of ORE, I hereby certify that the within instrument was filed in this office
for record on the 1st day of MAY; 1970, at 9 o'clock Am. (signed)

FILED
RECEIVED

[Signature] by [Signature]
(COUNTY OFFICIAL) (DEPUTY)

REGISTERED
OREGON
LAND SURVEYOR

MAY 11 1970

COUNTY SURVEYOR
DOUGLAS COUNTY, ORE.

Form R6-7100-57 (9/66)

[Signature]
JULY 10, 1964
TOM O. McCULLOUGH
650