


CERTIFIED RECORD OF LAND CORNER MONUMENTATION

History of original corner establishment:

Corner established in 1857 by Harvey Gordon.

Re-established in 1929 by Eppstein.

Old skid & cat road destroyed - Eppstein -
SW, NE and SE BT

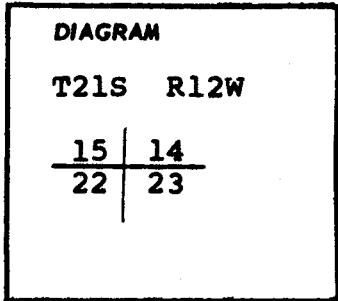

Description of corner evidence found:

Found 2½"x2½" post set by C.S. Eppstein in 1929 - scribing visible - *Pen. #6*
from which

26" fir brs. S46W 40.0 ft. - face pitched over
This BT is not an original according to Eppstein - it was
scribed between 1890 and 1895. 4 notched & x scribed - with tags


42" fir snag brs. N28W 32.3 ft. - face visible
axe marks - has 4 notched & x scribed in tree. Eppstein
does not make reference to, but believe same as above.

62" fir stump brs. N38W 32.3 ft. (cut low to ground)
No evidence of face set by Eppstein in 1929.

Description of monument and accessories established to perpetuate the original location of this corner

Set 2"x30" iron pipe with brass cap mkd

T21S R12W

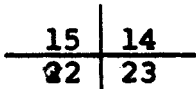

1970
650 from which

6" alder brs. S44E 9.6 ft. - scribed S23 BT - with tag

32" spruce brs. N23E 45.6 ft. - scribed S14 BT - with tag

Set 2 fence posts with signs ± 5 ft. north facing west
± 5 ft. east facing south

Office of SURVEYOR County of DOUGLAS
State of ORE, I hereby certify that the within instrument was filed in this office
for record on the 12th day of MAY, 1970, at 9 o'clock PM

J. C. D. ... by *...*
(COUNTY OFFICIAL) (DEPUTY)

REGISTERED
OREGON
LAND SURVEYOR

Tom O. McCullough
JULY 10, 1964
TOM O. McCULLOUGH
650

#25