

RESTORED CORNER FOR STATE OF OREGON--DEPARTMENT OF FORESTRY

One quarter corner for Section 13 (East side), T22S, R12W, W.M. Douglas County, Oregon.

ORIGINAL

Post (missing, reported destroyed by Slang in 1910) from which a:

- 28" Fir bears N86° E 12 lks.; now 36" Wind fall, axe work visible.
- 24" Fir bears S 5° W 36 lks.; now missing.
- 35" Fir snag 75' tall bears S 65½° E 40.1 ft. to face; scribes ¼ visible in open face, no record of restoration.

RESTORATION by C. A. Slang, 1910.

Post (missing) from which a:

- 42" Fir bears S 80° W 44 lks.; now 44" stump in place, scribes ¼ l visible.
- 36" Fir bears N 49½° W 185 lks.; now 42", 56.1 ft., X above grown over face.

RESTORED


Set 1½" x 36" galvanized iron pipe with 3" bronze cap marked "OREGON STATE BOARD OF FORESTRY ¼ S13 1970 RS359", 34 inches in ground, and from which a:

- 45" Fir (Slang's) bears N 49½° W 55.7 ft. to face; scribed RS359.
- 37" Fir bears S 49° W 85.5 ft. to face; scribed ¼ S 13 BT.

Set 4" x 4" x 72" white painted Cedar post 1.0 ft. NE of corner pipe. Oregon State Forestry Department metal location poster on 45" Fir BT N 49½° W 55.7 ft.

Dated May 21, 1970

Restored by C. Wayne Cook under my direction.  
C. Wayne Cook, Transitman

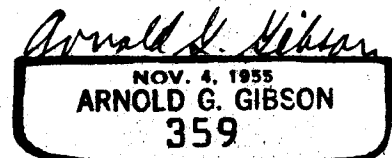

Present and witnessed by Steven F. Howard

1\*86-22-11  
#65-22-12

FILED  
RECEIVED

JUN 17 1970

COUNTY SURVEYOR  
DOUGLAS COUNTY, ORE.

C. S. File No. 55/54-1