

RESTORED CORNER FOR STATE OF OREGON--DEPARTMENT OF FORESTRY

Section corner common to Sections 14 and 23, T23S, R10W, W.M., Douglas County, Oregon.

ORIGINAL

Fir Post (destroyed by Levi Walker in 1906) from which a:

- 60" Fir bears N30°E 8 lks.; now 60" stump in place, bottom of face with axe work visible.
- 24" Fir bears S45°E 154 lks.; now 40" stump in place, old are work visible.
- 60" Fir bears S45°W 6 lks.; (obliterated by Levi Walker) now 55" stump in place.
- 50" Fir bears N55°W 36 lks.; (obliterated by Levi Walker) now missing, point falls in old cut road.

RESTORATION by Levi Walker 1906

Fir Post (missing) from which a:

Closing corner 15 and 22 bears North 1.57 chs.; in place.

RESTORED



Set 1½" x 36" galvanized iron pipe with 3" bronze cap marked "OREGON STATE BOARD OF FORESTRY T23S S14 S23 S22 R10W 1970 RS359", 34 inches in ground at corner point and from which a:

- 8" Fir bears N82°E 11.4 ft. to face; scribed T23S R10W S14 BT RS359.
- 5" Fir bears S46°E 68.1 ft. to face; bark scribed T23S R10W S23 BT.

Set 4" x 4" x 72" white painted Cedar post 1.3 ft. North of corner pipe. Oregon State Forestry Department metal location poster on 8" Fir BT N82°E 11.4 ft.

Dated May 19, 1970

Restored by Lloyd D. Smith under my direction.
Lloyd D. Smith, Transitman

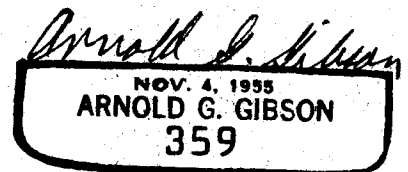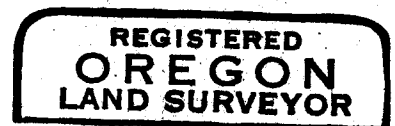

Present and witnessed by Charles W. Cook

#80-1
FILED
RECEIVED

JUN 17 1970

COUNTY SURVEYOR
DOUGLAS COUNTY, ORE.