

RESTORED CORNER FOR STATE OF OREGON-DEPARTMENT OF FORESTRY

One quarter corner common to Sections 14 and 15, Township 22 South, Range 11 West, W.M., Douglas County, Oregon.

ORIGINAL

Post (missing, found cedar post 1 ft. SW) from which a:

- 6" Fir bears S65°E 35 lks.; now 38", exposed scribes S1.
- 8" Fir bears S23°W 83 lks.; now 34" snag 50' tall, center 18" rotted out.

RESTORATION by Elliott State forest survey, 1941

Cedar post (see above)

RESTORED


Set 1½" x 36" galvanized iron pipe with 3" bronze cap marked "OREGON STATE BOARD OF FORESTRY 1/4 S15 S14 1970 RS359", 34 inches in ground, Elliott post alongside, in mound of rock, and from which a:

- 11" Fir bears S38½°W 27.7 ft. to face; scribed ½ S15 BT RS359.
- 3' x 3' point of sandstone bedrock bears S77½°E 7.9 ft to face; chiseled 6" x 60.

Set 4" x 4" x 72" white painted Cedar post 3.8 ft. NW of corner pipe. Oregon State Forestry Department metal location poster on 38" original fir BT S65°E 21.6 ft.

Dated August 10, 1970

Restored by C. Wayne Cook under my direction.
C. Wayne Cook, Transitman

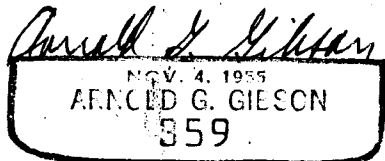

Present and witnessed by David R. Brown
James D. Taylor
Steven G. Simons
Lawrence L. Baughman

FILED
RECEIVED

AUG 20 1970

COUNTY SURVEYOR
DOUGLAS COUNTY, ORE

87

File No. 55/154-8