

RESTORED CORNER FOR STATE OF OREGON--DEPARTMENT OF FORESTRY

Section corner common to Sections 4, 5, 8 and 9, T22S, R11W, W.M., Douglas County, Oregon.

ORIGINAL

Post (missing, found Elliott 4" x 4" x 4' white post in mound of rock in place) from which a:

- 36" Fir bears N48°E 66 lks.; missing.
- 36" Fir bears S58°E 20 lks.; now 20" x 12' rotted windfall.
- 24" Fir bears S57°W 45 lks.; now 31" windfall downhill out of place, exposed scribes T2 11 (face N83W 24.6 ft.).
- 24" Cedar bears N36°W 23 lks.; now 30" windfall, exposed orig. axe work, face rotted out, no scribes found.

RESTORATION by Elliott State forest survey, 1941

Cedar Post (see above).

RESTORED


Set 1½" x 36" galvanized iron pipe with 3" bronze cap marked "OREGON STATE BOARD OF FORESTRY T22S R11W S4 S5 S8 S9 1970 RS 359" 32 inches in ground, in Elliott post hole, with Elliott post laying alongside, in mound of rock, and from which a:

- 24" Fir bears N06°W 116.5 ft. to face; scribed T22S R11W S5 BT RS 359.
- 42" Fir bears S80°E 38.7 ft. to face; scribed T22S R11W S9 BT.
- 43" Fir bears N32°E 41.6 ft. to face; scribed T22S R11W S4 BT.

Set 4" x 4" x 72" white painted Cedar post 2.0 ft. S45W of corner pipe. Oregon State Forestry Department metal location poster on 24" Fir BT N06°W.

Dated September 29, 1970

Restored by Lloyd D. Smith under my direction.
Lloyd D. Smith, Transitman

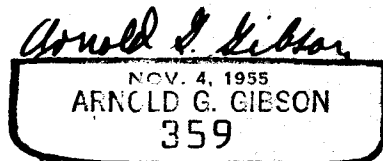

Present and witnessed by James D. Taylor
Lawrence L. Baughman
Dale E. Redding

FILED
RECEIVED

OCT 26 1970

COUNTY SURVEYOR
DOUGLAS COUNTY, ORE.

#89

O.K.
J.W.B.

C. S. File No. 55/154-9