


U S PUBLIC LAND CORNERS
 3 Twp. 26 S Range 8 W M.
 WEYERHAEUSER TIMBER CO.

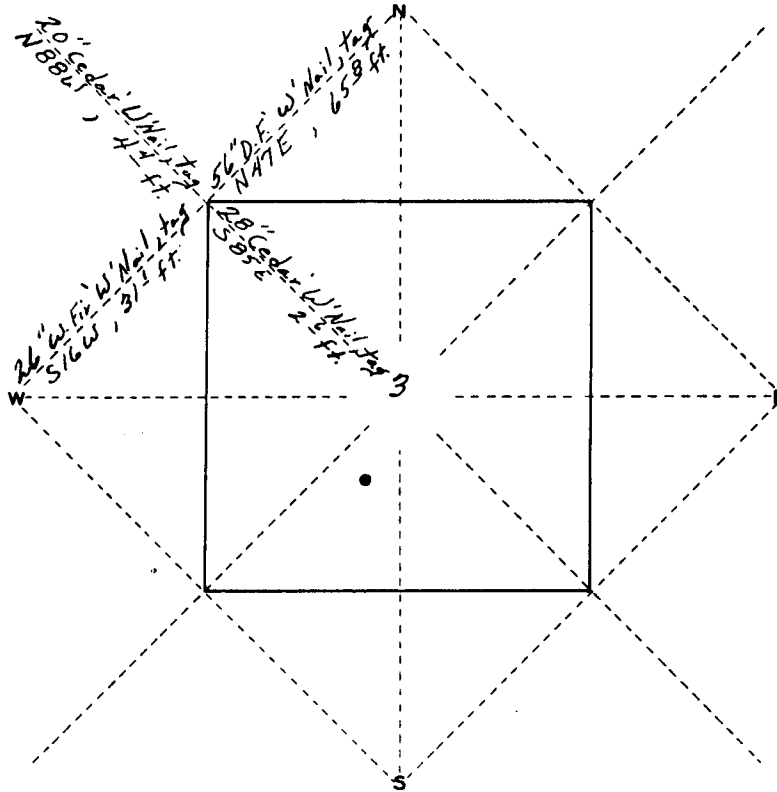

COR.	IDENTIFIED BY			WITNESSED BY			DATE	BY WHOM
	B.T.S.	POST	STONE	MKS.	PIPE	TAG		
NE								
N 1/4								
NW 3				✓		✓	6/63	Stevens Kunkle Queen Smith
W 1/4								
SW								
S 1/4								
SE 4				✓			11/68	Minister, Lester
E 1/4								

FIELD RECORD FOR OFFICE DATA

WITNESSED BY
 FORM 402 WTCO.

Key # 37

FILED
 RECEIVED

JUN 17 1970

COUNTY SURVEYOR
 DOUGLAS COUNTY, ORE.