


U S PUBLIC LAND CORNERS
 S 4 Twp. 26 S Range 8 W M.
 WEYERHAEUSER TIMBER CO.

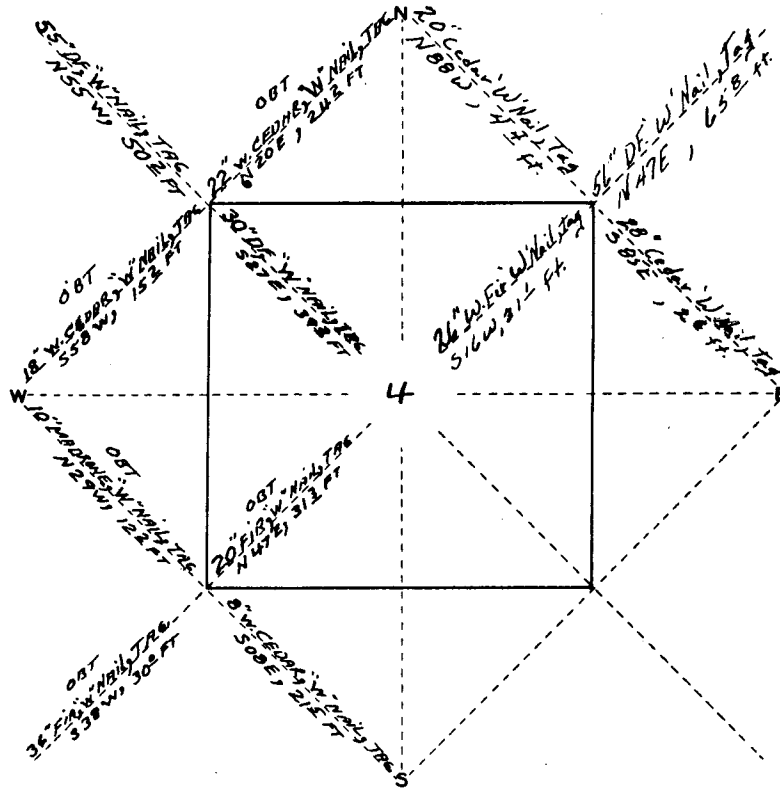

COR.	IDENTIFIED BY				DATE	BY WHOM
	B.T.S.	POSTSTONE	MKS.	PIPE		
#31 NE	3		✓		4	6/63 Smith Stevens Queen Kunkle
N 1/4						
#32 NW	2		✓		4	9/62 Reppeta, Stevens & CREW
W 1/4						
SW	4	✓	✓		4	5/63 STEVENS & PARTY
S 1/4						
SE						
E 1/4						

FIELD RECORD FOR OFFICE DATA

WITNESSED BY
 FORM 402 WTCO.

FILED
 RECEIVED

JUN 17 1970

COUNTY SURVEYOR
 DOUGLAS COUNTY, ORE.

2
 C.S. 55-155A