


U S PUBLIC LAND CORNERS
 S 5 Twp. 26 S Range 8 W.M.
 WEYERHAEUSER TIMBER CO.

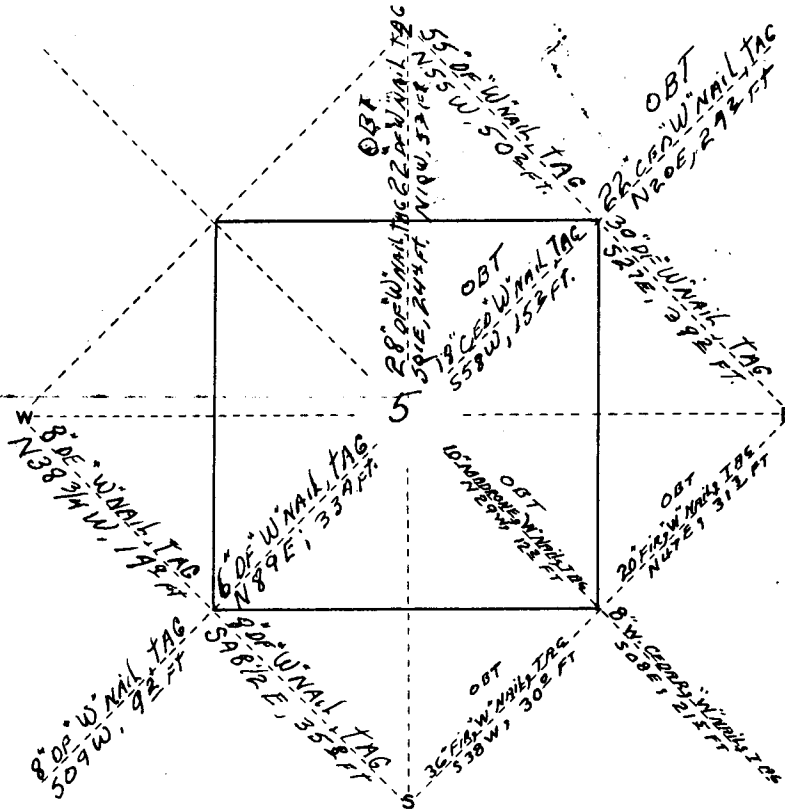

COR.	IDENTIFIED BY				WITNESSED BY		DATE	BY WHOM
	BT'S	POST	STONE	MKS.	PIPE	TAG		
NE	2			✓		4	9/62	REPPETO - STEVENS SMITH - KUNKLE
N 1/4	1			✓		2	9/62	REPPETO - STEVENS SMITH - KUNKLE
NW								
W 1/4								
SW				✓		4	10/61	REPPETO - STEVENS
S 1/4								
SE	4	✓		✓		4	5/63	STEVENS & PARTY
E 1/4								

FIELD RECORD FOR OFFICE DATA

WITNESSED BY

FORM 402 WTCO.

FILED
 RECEIVED

JUN 17 1970

COUNTY SURVEYOR
 DOUGLAS COUNTY, ORE.

C. S. File No. 55/155A-3