


U S PUBLIC LAND CORNERS
 S_e ³ Twp. 26.S Range 8W W.M.
 WEYERHAEUSER TIMBER CO.

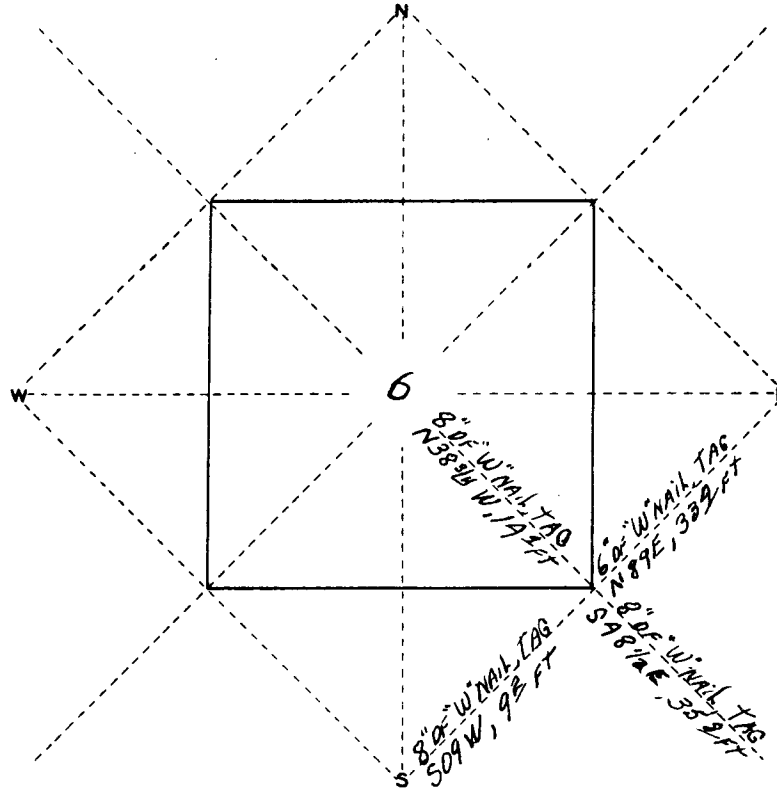

COR.	IDENTIFIED BY			WITNESSED BY		DATE	BY WHOM
	B.T.S.	POST	STONE	MKS.	PIPE		
NE							
N $\frac{1}{4}$							
NW							
W $\frac{1}{4}$							
SW							
S $\frac{1}{4}$							
SE				✓		4	9/61 Reppeto-STEVENS
E $\frac{1}{4}$							

FIELD RECORD FOR OFFICE DATA

WITNESSED BY
 FORM 402 WTCo.

FILED
 RECEIVED

JUN 17 1970

COUNTY SURVEYOR
 DOUGLAS COUNTY, ORE.

C. S. File No. 55/155A-4