


U S PUBLIC LAND CORNERS  
 7 Twp. 265 Range 8 W.M.  
 WEYERHAEUSER TIMBER CO.

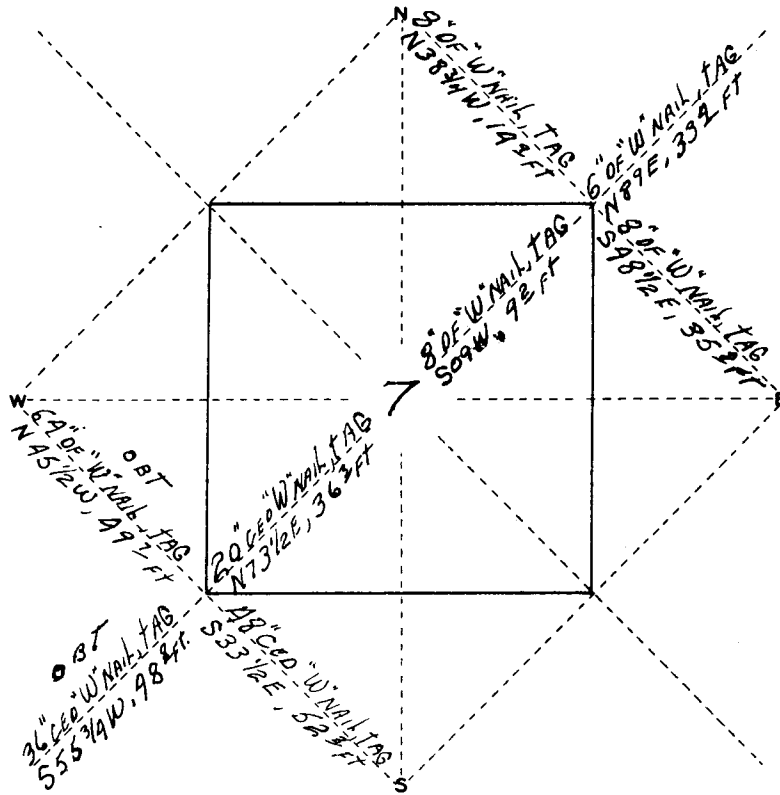

COR.	IDENTIFIED BY			WITNESSED BY		DATE	BY WHOM
	BT'S	POST	STONE	MKS.	PIPE		
NE				✓		4	10/61 REPPETO - STROGENS
N 1/4							
NW							
W 1/4							
SW	3			✓		5	10/61 STROGENS - KAUFFMAN HUNPHREYS - KUNHE
S 1/4							
SE							
E 1/4							

FIELD RECORD FOR OFFICE DATA

-----  
 -----  
WITNESSED BY

FORM 402 WTCO.

FILED  
 RECEIVED

JUN 17 1970

COUNTY SURVEYOR  
 DOUGLAS COUNTY, ORE.

55/155 A-5