


U S PUBLIC LAND CORNERS
 S 08 Twp. 26 S Range 8 W.M.
 WEYERHAEUSER TIMBER CO.

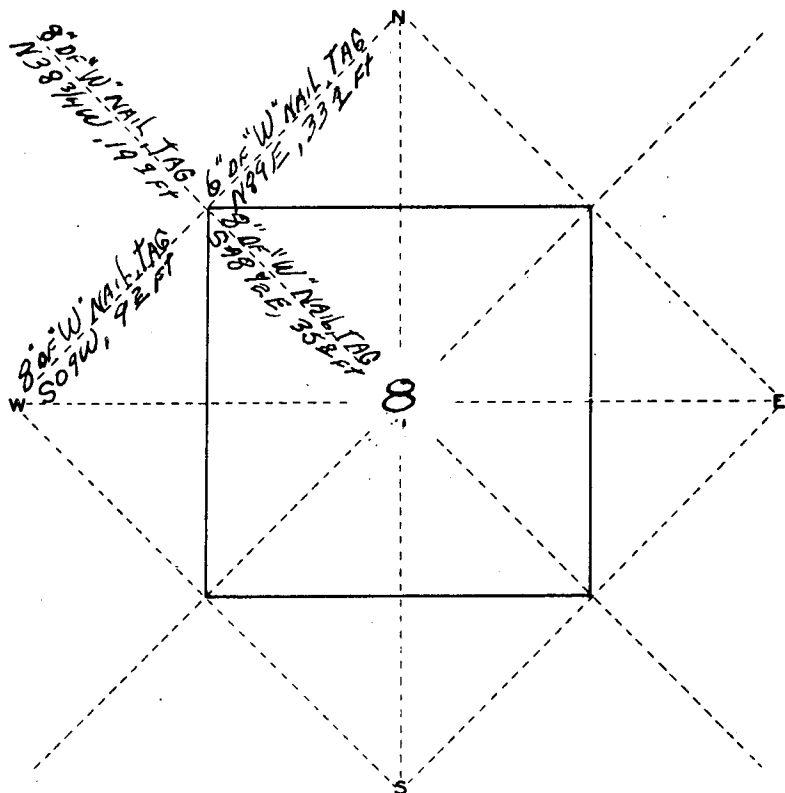

COR.	IDENTIFIED BY			WITNESSED BY		DATE	BY WHOM
	BT'S	POST	STONE	MKS.	PIPE		
NE							
N 1/4							
NW				✓		4	1961 Reppeto - Stevens
W 1/4							
SW							
S 1/4							
SE							
E 1/4							

FIELD RECORD FOR OFFICE DATA

WITNESSED BY
 FORM 402 WTCO.

FILED
 RECEIVED

JUN 17 1970

COUNTY SURVEYOR
 DOUGLAS COUNTY, ORE.

C. S. File No. 55/155A-6