


U S PUBLIC LAND CORNERS
 S 8 Twp. 26S Range 8 M.
 WEYERHAEUSER TIMBER CO.

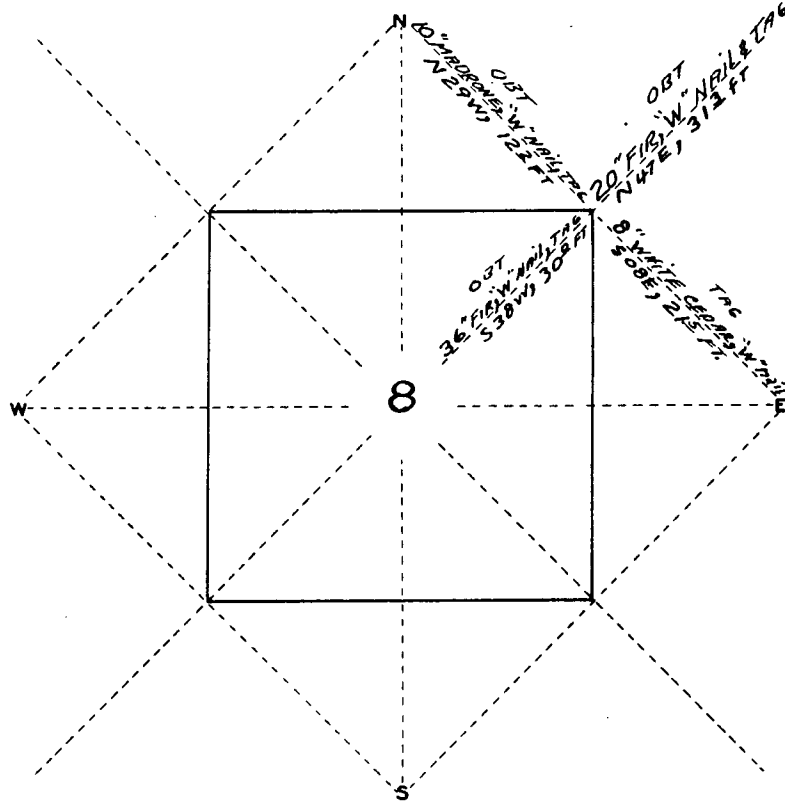

| COR. | IDENTIFIED BY | | | WITNESSED BY | | | DATE | BY WHOM |
|-------|---------------|------|-------|--------------|------|-----|------|-----------------|
| | BT'S | POST | STONE | MKS. | PIPE | TAG | | |
| NE | 4 | ✓ | | ✓ | | 4 | 5/63 | STEVENS & PARTY |
| N 1/4 | | | | | | | | |
| NW | | | | | | | | |
| W 1/4 | | | | | | | | |
| SW | | | | | | | | |
| S 1/4 | | | | | | | | |
| SE | | | | | | | | |
| E 1/4 | | | | | | | | |

FIELD RECORD FOR OFFICE DATA

WITNESSED BY

FORM 402 WTCo.

FILED
 RECEIVED

JUN 17 1970

COUNTY SURVEYOR
 DOUGLAS COUNTY, ORE.

C. S. File No. 55/155A-7