


U S PUBLIC LAND CORNERS
 14 Twp. 26 S Range 8 M.
 Weyerhaeuser Company

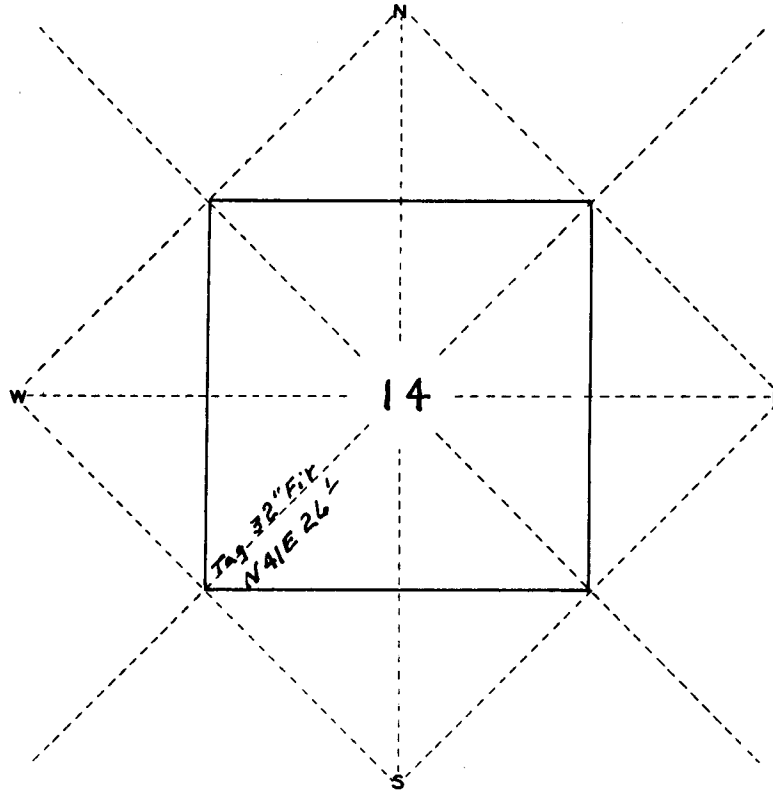

COR.	IDENTIFIED BY			WITNESSED BY		DATE	BY WHOM
	BT'S	POST	STONE	MKS.	PIPE		
NE							
N $\frac{1}{4}$							
NW							
W $\frac{1}{2}$							
SW	3			✓		2	11/68 Williams
S $\frac{1}{4}$							
SE							
E $\frac{1}{2}$							

FIELD RECORD FOR OFFICE DATA

WITNESSED BY

FORM 402

FILED
 RECEIVED

JUN 17 1970

COUNTY SURVEYOR
 DOUGLAS COUNTY, ORE.

C. S. File No. 55/155 A-9