


U S PUBLIC LAND CORNERS
 c. 15 Twp. 26 S Range 8 M.
Weyerhaeuser Company

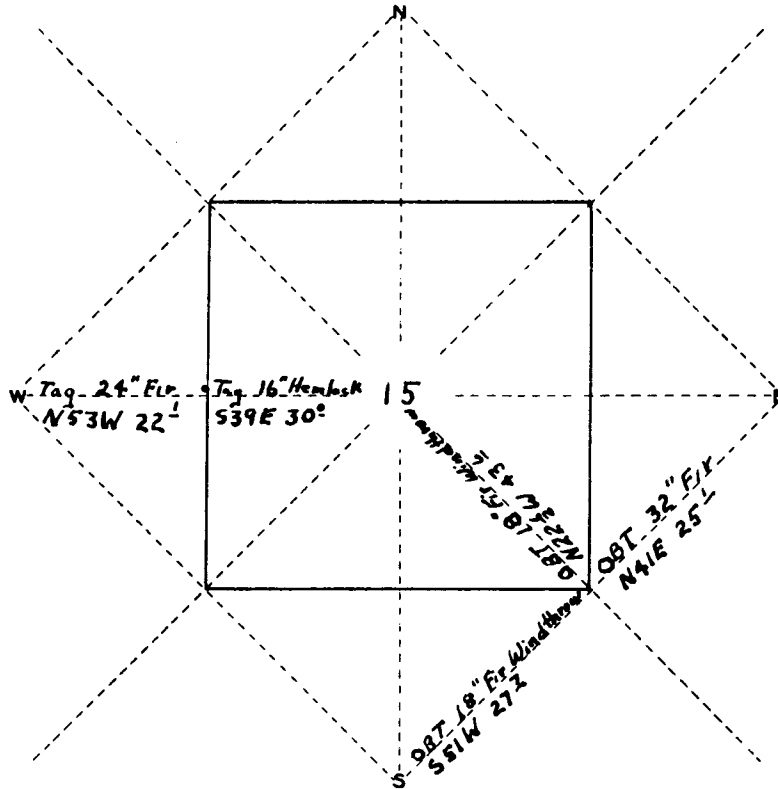

COR.	IDENTIFIED BY			WITNESSED BY			DATE	BY WHOM
	B.T.S.	POST	STONE	MKS.	PIPE	TAG		
NE								
N $\frac{1}{4}$								
NW								
W $\frac{1}{4}$	2 ¹					2	12/68	Williams
SW								
S $\frac{1}{4}$								
SE	3			✓		2	12/68	Williams
E $\frac{1}{4}$				✓		✓	12/68	Williams

FIELD RECORD FOR OFFICE DATA

E $\frac{1}{4}$ Found Cruiser's Marks but no definite B.T.S.
 S $\frac{1}{4}$ Could not find Any Signs of The Corner (Williams)

WITNESSED BY

FORM 402

FILED
 RECEIVED

JUN 17 1970

COUNTY SURVEYOR
 LOUGLAS COUNTY, ORE.

55/155 A-10