


U S PUBLIC LAND CORNERS
 S 16 Twp. 26S Range 8 W M.
 WEYERHAEUSER TIMBER CO.

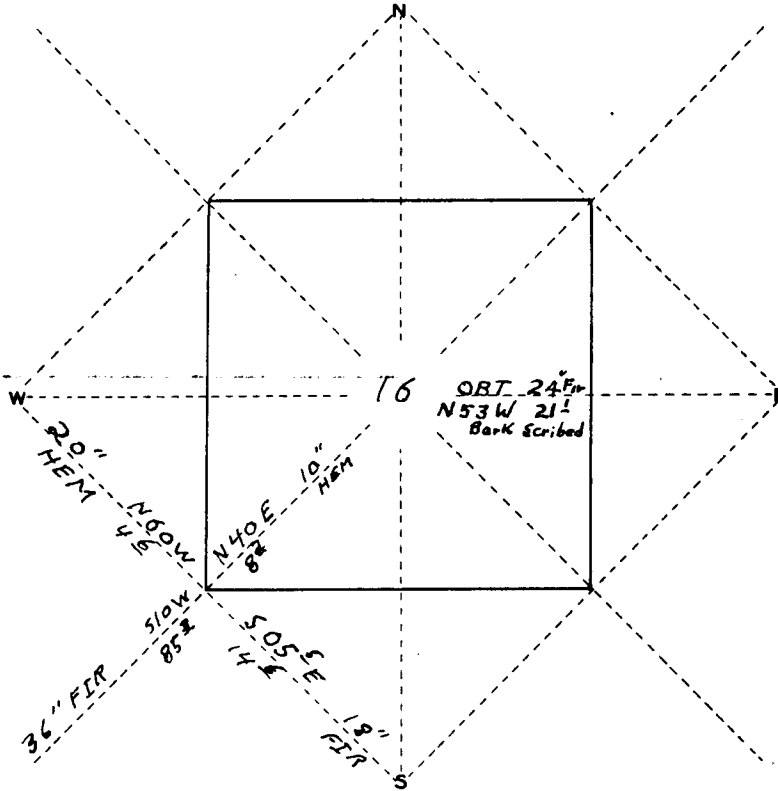

| COR. | IDENTIFIED BY | | | WITNESSED BY | | DATE | BY WHOM |
|-------|---------------|------|-------|--------------|------------|------|-----------------------------|
| | BT'S | POST | STONE | MKS. | PIPE | | |
| NE | ✓ | | | ✓ | | ✓ | 12/68 Williams |
| N 1/4 | | | | | | | |
| NW | | | | | | | |
| W 1/4 | | | | | | | |
| SW | 2 | | | | CEDAR POST | 4 | 1/68 HOLMES-MORGAN-McMILLAN |
| S 1/4 | | | | | | | |
| SE | | | | | | | |
| E 1/4 | 1 | | | | | #2 | 12/68 Williams |

FIELD RECORD FOR OFFICE DATA

WITNESSED BY
 FORM 402 WTCO.

FILED
 RECEIVED

JUN 17 1970

COUNTY SURVEYOR
 DOUGLAS COUNTY, ORE.

C. S. File No. 55/155A-11