


U S PUBLIC LAND CORNERS
 C. 17 Twp. 26 S Range 8 M.
WEYERHAEUSER TIMBER CO.

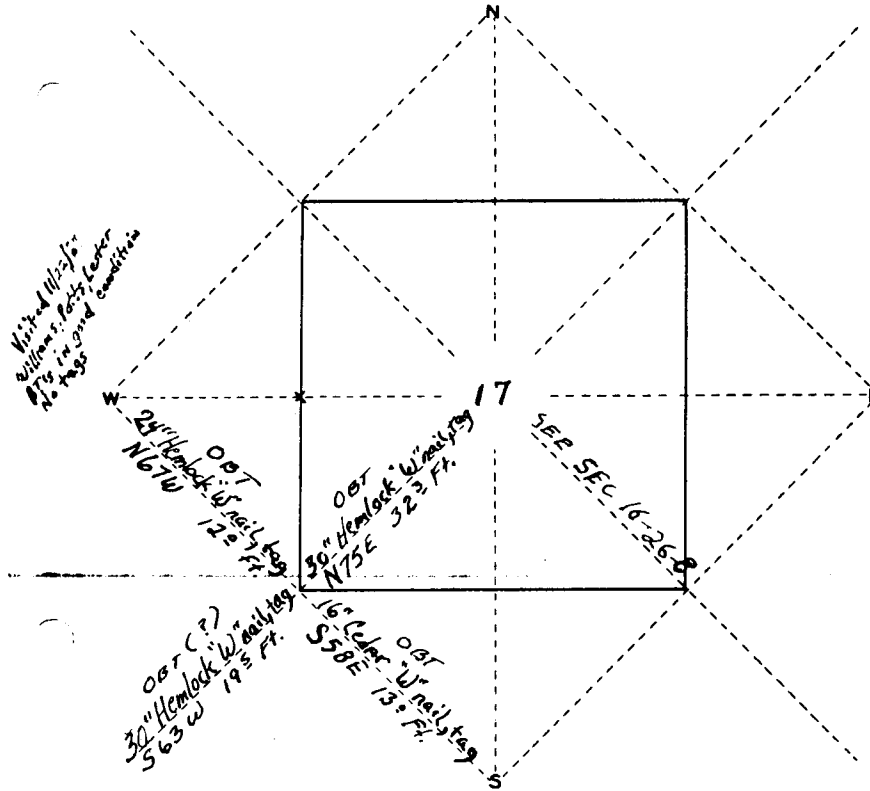

COR.	IDENTIFIED BY			WITNESSED BY		DATE	BY WHOM
	BT'S	POST	STONE	MKS.	PIPE		
NE							
N $\frac{1}{4}$							
NW							
W $\frac{1}{4}$	1					11/67	WILLIAMS POTTS LESTER
SW	4				✓	4	11/67 Williams Lester
S $\frac{1}{4}$							
SE							
E $\frac{1}{4}$							

FIELD RECORD FOR OFFICE DATA

WITNESSED BY
 FORM 402 WTGO.

FILED
 RECEIVED

JUN 17 1970

COUNTY SURVEYOR
 DOUGLAS COUNTY, ORE.

C. S. File No. 55/155A-12