


U S PUBLIC LAND CORNERS
 S018 Twp. 26 S Range 84 W.M.
 WEYERHAEUSER TIMBER CO.

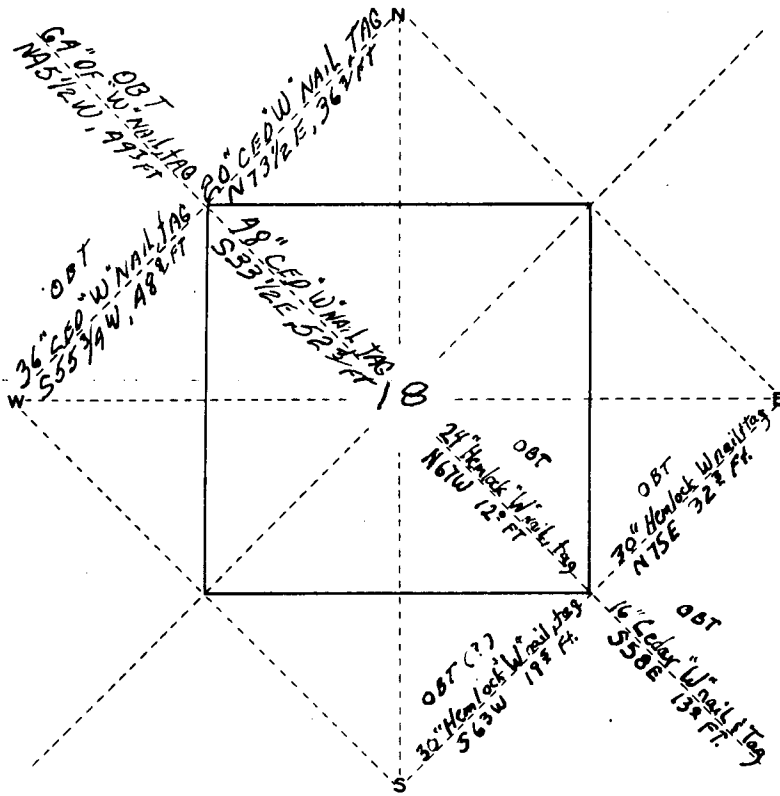

COR.	IDENTIFIED BY			WITNESSED BY		DATE	BY WHOM
	BT'S	POSTSTONE	MKS.	PIPE	TAG		
NE							
N $\frac{1}{4}$							
NW	3		✓		5	10/61	STEVENS-KAUFFMAN HUMPHREYS-KUNKLE
W $\frac{1}{4}$							
SW							
S $\frac{1}{4}$							
SE	4			✓	4	11/67	Williams Lester
E $\frac{1}{4}$	2					11/67	Williams-Potts-Lester

FIELD RECORD FOR OFFICE DATA

WITNESSED BY
 FORM 402 WTCO.

FILED
 RECEIVED

JUN 17 1970.

COUNTY SURVEYOR
 DOUGLAS COUNTY, ORE.