


U S PUBLIC LAND CORNERS
 20 Twp. 26 S Range 8 M.
 WEYERHAEUSER TIMBER CO.

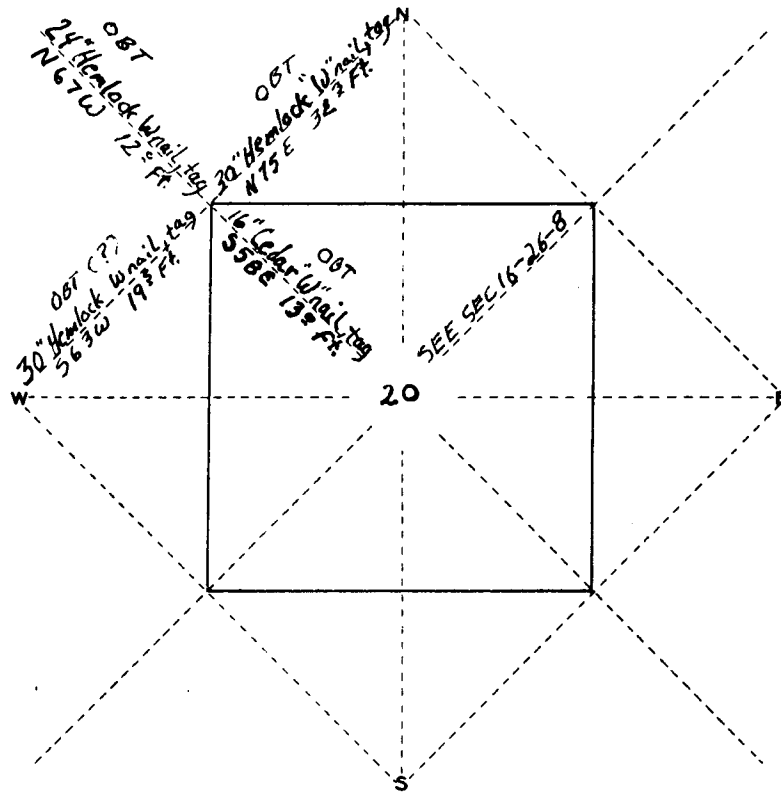

| COR. | IDENTIFIED BY | | | WITNESSED BY | | DATE | BY WHOM |
|-------|---------------|------|-------|--------------|------|------|----------------------|
| | B.T.S. | POST | STONE | MKS. | PIPE | | |
| NE | | | | | | | |
| N 1/4 | | | | | | | |
| NW | 4 | | | | - | 4 | "/67 Williams Lester |
| W 1/4 | | | | | | | |
| SW | | | | | | | |
| S 1/4 | | | | | | | |
| SE | | | | | | | |
| E 1/4 | | | | | | | |

FIELD RECORD FOR OFFICE DATA

WITNESSED BY

FORM 402 WTCO.

FILED
 RECEIVED

JUN 17 1970

COUNTY SURVEYOR
 DOUGLAS COUNTY, ORE.

55/155 A \$