


**U S PUBLIC LAND CORNERS**  
 22 Twp. 26 S Range 8 M.  
**Weyerhaeuser Company**

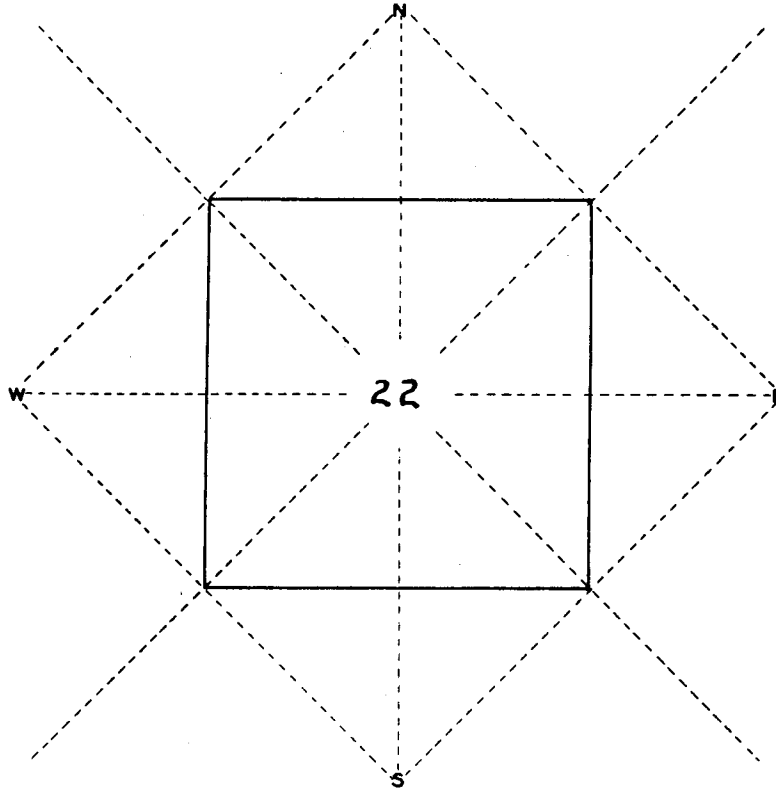

COR.	IDENTIFIED BY			WITNESSED BY		DATE	BY WHOM
	BT'S	POST	STONE	MKS.	PIPE		
NE	3			✓		2	12/68 Williams
N $\frac{1}{4}$							
NW							
W $\frac{1}{4}$				.			
SW							
S $\frac{1}{4}$							
SE							
E $\frac{1}{4}$							

FIELD RECORD FOR OFFICE DATA

-----  
 -----  
WITNESSED BY

FORM 402

FILED  
 RECEIVED

JUN 17 1970

COUNTY SURVEYOR  
 DOUGLAS COUNTY, ORE.

C. S. File No. 55/155A-17