


U S PUBLIC LAND CORNERS
 23 Twp. 26 S Range 8 M.
Weyerhaeuser Company

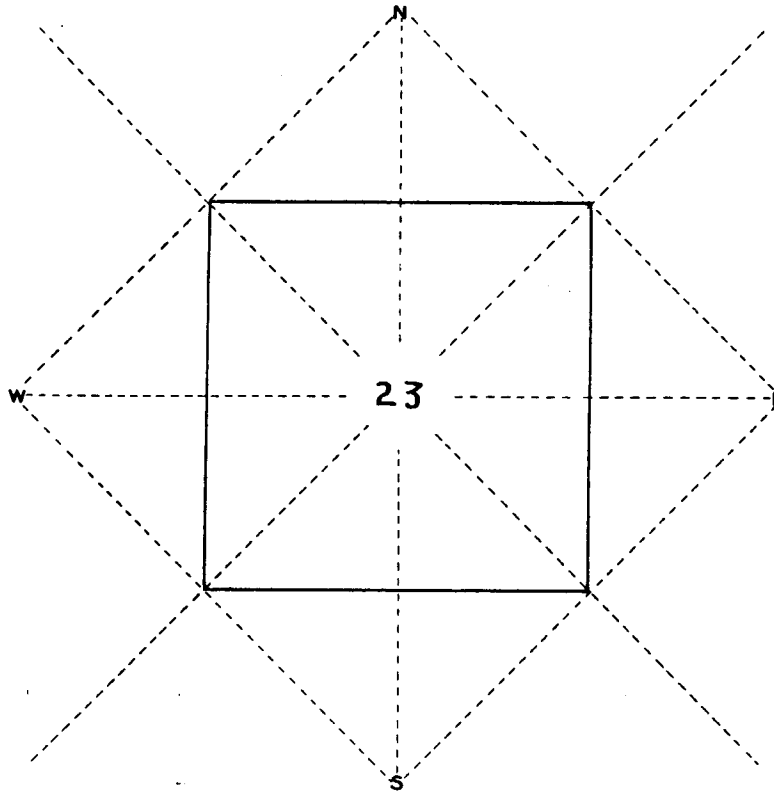

COR.	IDENTIFIED BY			WITNESSED BY		DATE	BY WHOM
	BT'S	POST	STONE	MKS.	PIPE		
NE							
N $\frac{1}{4}$							
NW	3			✓		2	12/68 Williams
W $\frac{1}{4}$							
SW							
S $\frac{1}{4}$							
SE							
E $\frac{1}{4}$							

FIELD RECORD FOR OFFICE DATA

WITNESSED BY

FORM 402

FILED
 RECEIVED

JUN 17 1970

COUNTY SURVEYOR
 DOUGLAS COUNTY, ORE.

C. S. File No. 55/155A-18