


U.S. PUBLIC LAND CORNERS
 3 Twp. 26 S Range 9 W M.
 WEYERHAEUSER TIMBER CO.

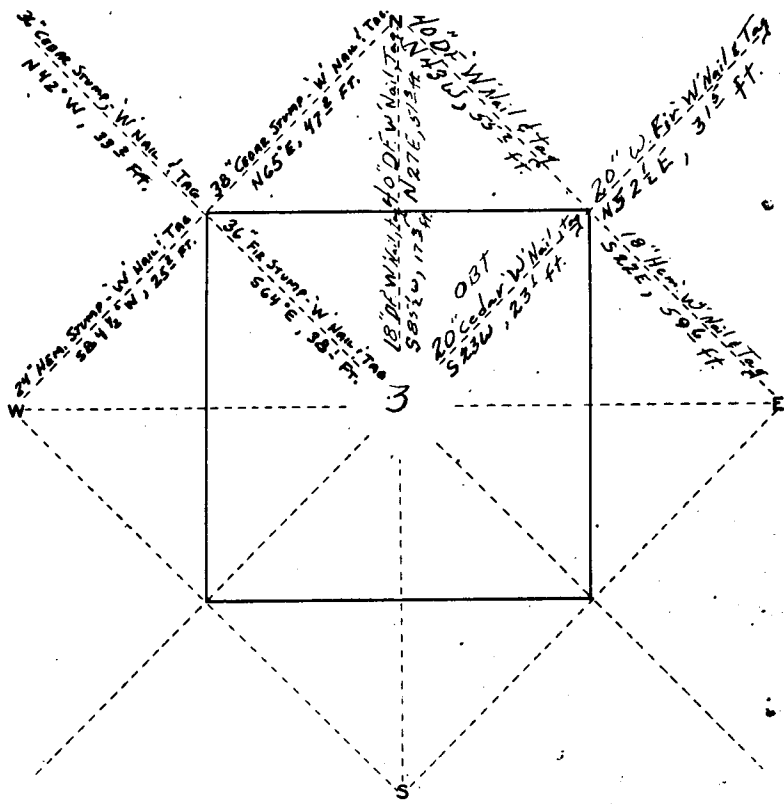

COR.	IDENTIFIED BY			WITNESSED BY		DATE	BY WHOM	
	B.T.S.	POST	STONE	MKS.	PIPE			TAG
NE	2					4	6/63	Ropeto Stevens Queen Kunkle Smith
N 1/4				✓		2	6/63	Stevens Kunkle Queen Smith
NW				✓		4	11/64	STEVENS - KUNKLE
W 1/4								
SW								
S 1/4								
SE	✓					✓		FOUND FOW
E 1/4								

FIELD RECORD FOR OFFICE DATA

WITNESSED BY
 FORM 402 WTCO.

FILED
 RECEIVED

JUN 17 1970

COUNTY SURVEYOR
 DOUGLAS COUNTY, ORE.

C. S. File No. 55/155 B-2