


QUARTER-QUARTER CORNERS AND CENTER SECTION

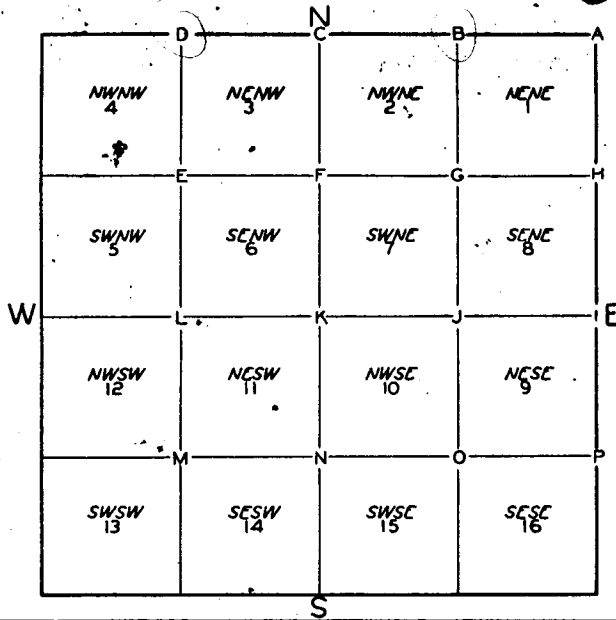

COR.	IRON PIPE	METAL TAGS	BEARINGS AND DISTANCES
B	✓	2	28" D.F. N 02 W 15 1/2 FT. 16" D.F. S 28 E 30 FT.
D	✓	2	44" D.F. N 33 E 12 1/2 FT. 24" D.F. S 46 W 44 1/2 FT.
E			
F			
G			
H			
J			
K			
L			
M			
N			
O			
P			

WITNESSED BY

FILED
RECEIVED

JUN 17 1970

COUNTY SURVEYOR
DOUGLAS COUNTY, ORE.

S ?
116 corners
N.W. 1/4