


U.S. PUBLIC LAND CORNERS
 S 11 Twp. 26 S Range 9 W W. M.
 WEYERHAEUSER TIMBER CO.

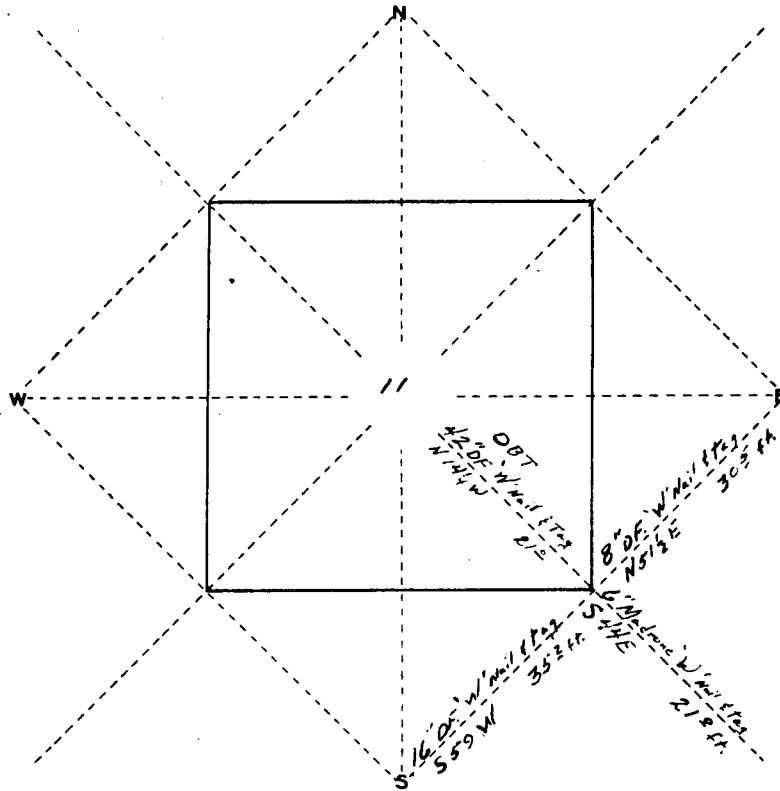

COR.	IDENTIFIED BY			WITNESSED BY			DATE	BY WHOM
	B.T.S.	POSTSTONE	MKS.	PIPE	TAG			
NE								
N 1/4								
NW								
W 1/4								
SW								
S 1/4								
SE	2		✓	✓	4	7/63	Stevens	Kunkle Smith
E 1/4								

FIELD RECORD FOR OFFICE DATA

WITNESSED BY
 FORM 402 WTCO.

FILED
 RECEIVED

JUN 17 1970

COUNTY SURVEYOR
 DOUGLAS COUNTY, ORE.

C. S. File No. 55/155B-4