


U.S. PUBLIC LAND CORNERS  
 S. 12 Twp. 26S Range 9W W.M.  
 WEYERHAEUSER TIMBER CO.

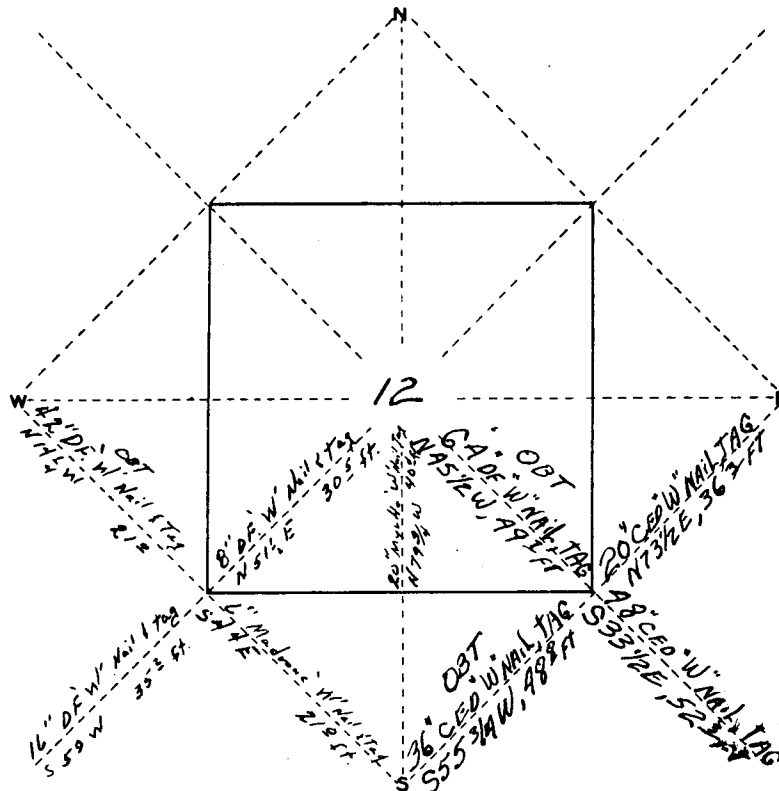

COR.	IDENTIFIED BY			WITNESSED BY			DATE	BY WHOM
	BT'S	POST	STONE	MKS.	PIPE	TAG		
NE								
N 1/4								
NW								
W 1/4								
SW	2			✓	✓	4	7/63	Stevens Kunkle & Smith
S 1/4					✓	2	7/63	Stevens Kunkle & Smith
SE	3			✓		5	10/61	STADENS - KUNKLE & HUMPHREYS
E 1/4								

FIELD RECORD FOR OFFICE DATA

-----

-----

WITNESSED BY

FORM 402 WTCo.

FILED  
 RECEIVED

JUN. 17 1970

COUNTY SURVEYOR  
 DOUGLAS COUNTY, ORE.

C. S. File No. 55/155 B-5