


U.S. PUBLIC LAND CORNERS  
 S. 14 Twp. 26 S Range 9 W.M.  
 WEYERHAEUSER TIMBER CO.

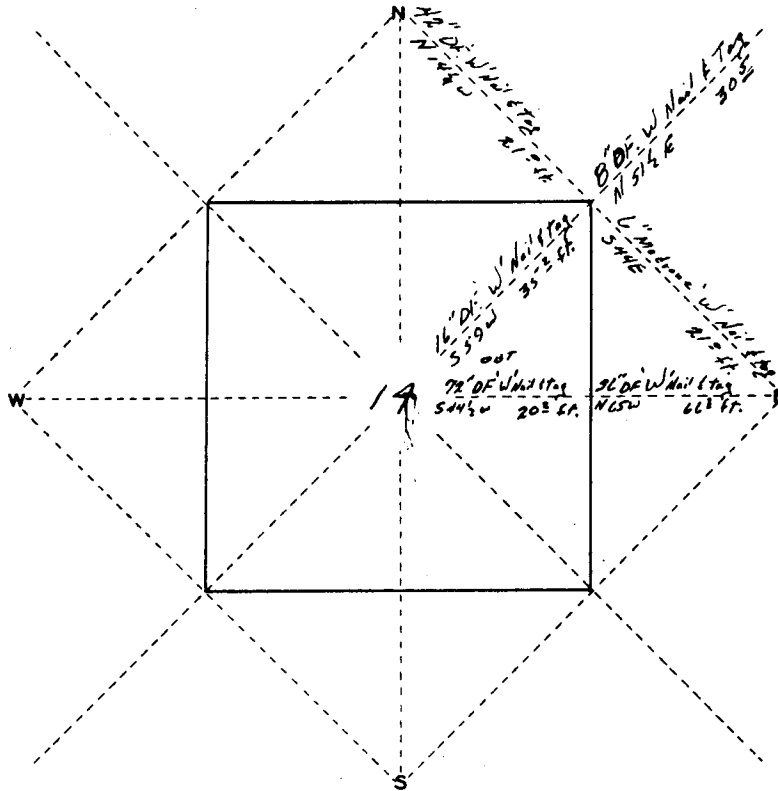

COR.	IDENTIFIED BY			WITNESSED BY			DATE	BY WHOM
	B.T.S.	POSTSTONE	MKS.	PIPE	TAG			
NE	2			✓	✓	4	7/63	Stevens Kunkle Smith
N 1/4								
NW								
W 1/4								
SW								
S 1/4								
SE								
E 1/4	1			✓	2	2	7/63	Stevens Kunkle Smith

FIELD RECORD FOR OFFICE DATA

-----

-----

WITNESSED BY

FORM 402 WTCO.

FILED  
 RECEIVED

JUN 17 1970

COUNTY SURVEYOR  
 DOUGLAS COUNTY, ORE.

C. S. File No. 55/155 B 7