


QUARTER-QUARTER CORNERS AND CENTER SECT

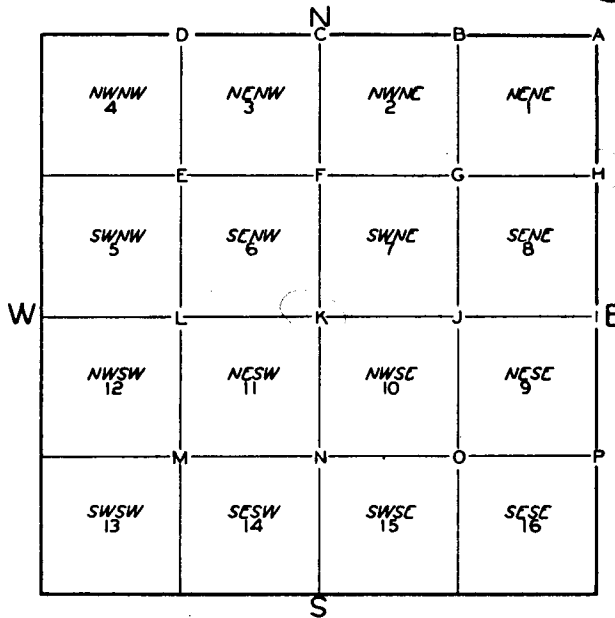

COR.	IRON PIPE	METAL TAGS	BEARINGS AND DISTANCES
B			
D			
E			
F			
G			
H	✓	1	60" OF 3/4" W NAIL TAG N70E 60 FT.
J			
K	✓	2	36" HEM W NAIL, TAG S38 1/2 W, 13 1/2 FT 18" HEM W NAIL, TAG N56 1/2 E 9 1/2 FT
L			
M			
N			
O			
P			

WITNESSED BY

FILED  
RECEIVED

JUN 17 1970

COUNTY SURVEYOR  
DOUGLAS COUNTY, ORE.