


U S PUBLIC LAND CORNERS
 S 22 Twp. 26 S Range 9 M.
 WEYERHAEUSER TIMBER CO.

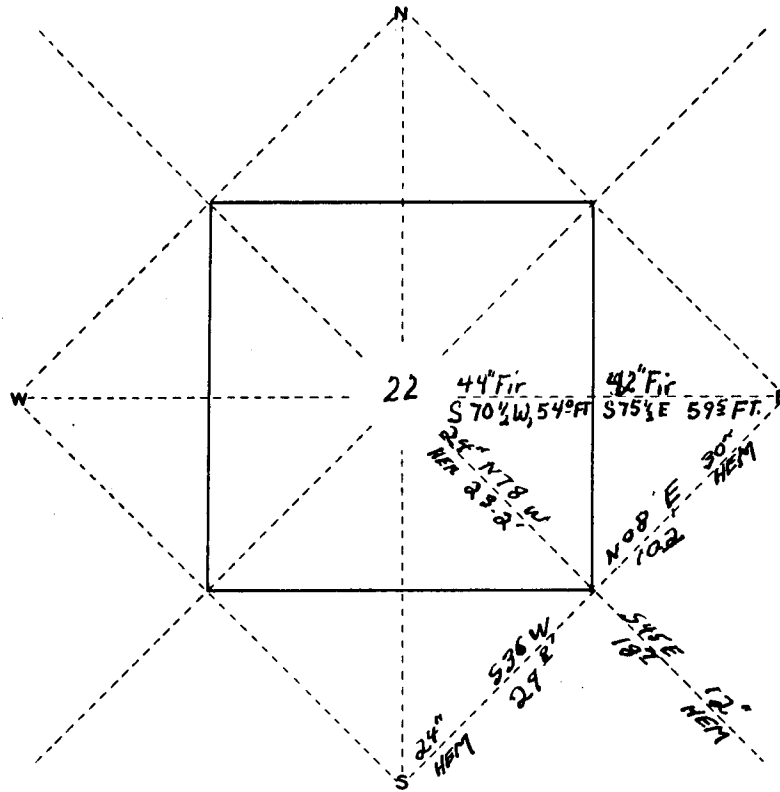

COR.	IDENTIFIED BY			WITNESSED BY		DATE	BY WHOM
	BT'S	POST	STONE	MKS.	PIPE		
NE							
N 1/4							
NW							
W 1/4							
SW							
S 1/4							
SE	4					2/68	WILLIAMS, LESTER
E 1/4	1					8/67	Williams, Thiemens, Iles

*Corrected
2/11/68*

FIELD RECORD FOR OFFICE DATA

WITNESSED BY
 FORM 402 WTCO.

FILED
 RECEIVED

JUN 17 1970

COUNTY SURVEYOR
 DOUGLAS COUNTY, ORE.

C. S. File No. 55/155 B-9