


U.S. PUBLIC LAND CORNERS  
 34 Twp. 26 SOUTH Range 9 EAST M.  
 WEYERHAEUSER TIMBER CO.

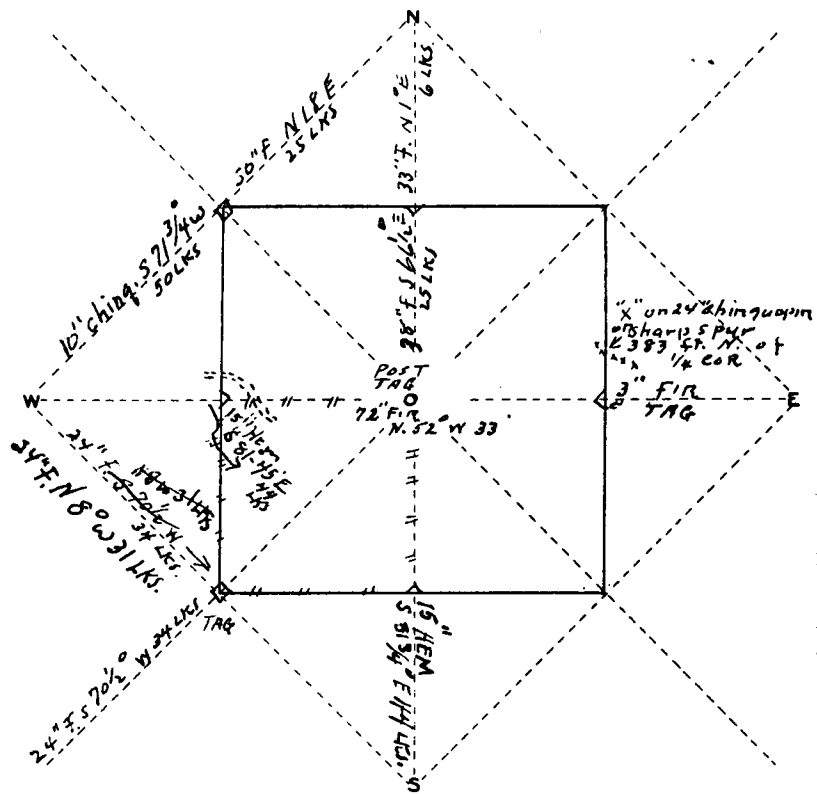

COR.	IDENTIFIED BY			WITNESSED BY		DATE	BY WHOM
	BT'S	POSTSTONE	MKS.	PIPE	TAG		
NE	Not found						
N $\frac{1}{4}$							
NW							
W $\frac{1}{4}$							
SW							
S $\frac{1}{4}$							
SE	Not Looked for						
E $\frac{1}{4}$							

FIELD RECORD FOR OFFICE DATA  
 NORTH AND SOUTH  $\frac{1}{2}$  AND EAST AND WEST CENTER  
 LINES RUN, CENTER OF SECTION MARKED BY  
 POST TAG. THE BOUNDARY OF THE SW QUARTER,  
 OWNED BY MENASHA PLYWOOD CORP., WAS BLAZED  
 ON JUNE 10<sup>th</sup> 1954

WITNESSED BY Howard T. Henderson

FORM 402 WTCO.

Sec 34

FILED  
 RECEIVED

JUN 17 1970

COUNTY SURVEYOR  
 JOUGLAS COUNTY, ORE.

C. S. File No. 55/155B-11