

T. 27-6 sec 23

SURVEY TO ESTABLISH PROPERTY CORNERS
LOT NO. 13, BLOCK NO. 2, SHINN'S ADDITION
FOR BILL LUTH; BY BAUGHMAN & ACKERET INC.


OCT. 5, 1970

COUNTY SURVEYORS FILE DATA
DO NOT REMOVE FROM OFFICE

REGISTERED
OREGON
LAND SURVEYOR

Glenn S. Baughman

JULY 14, 1961
GLENN S. BAUGHMAN
536

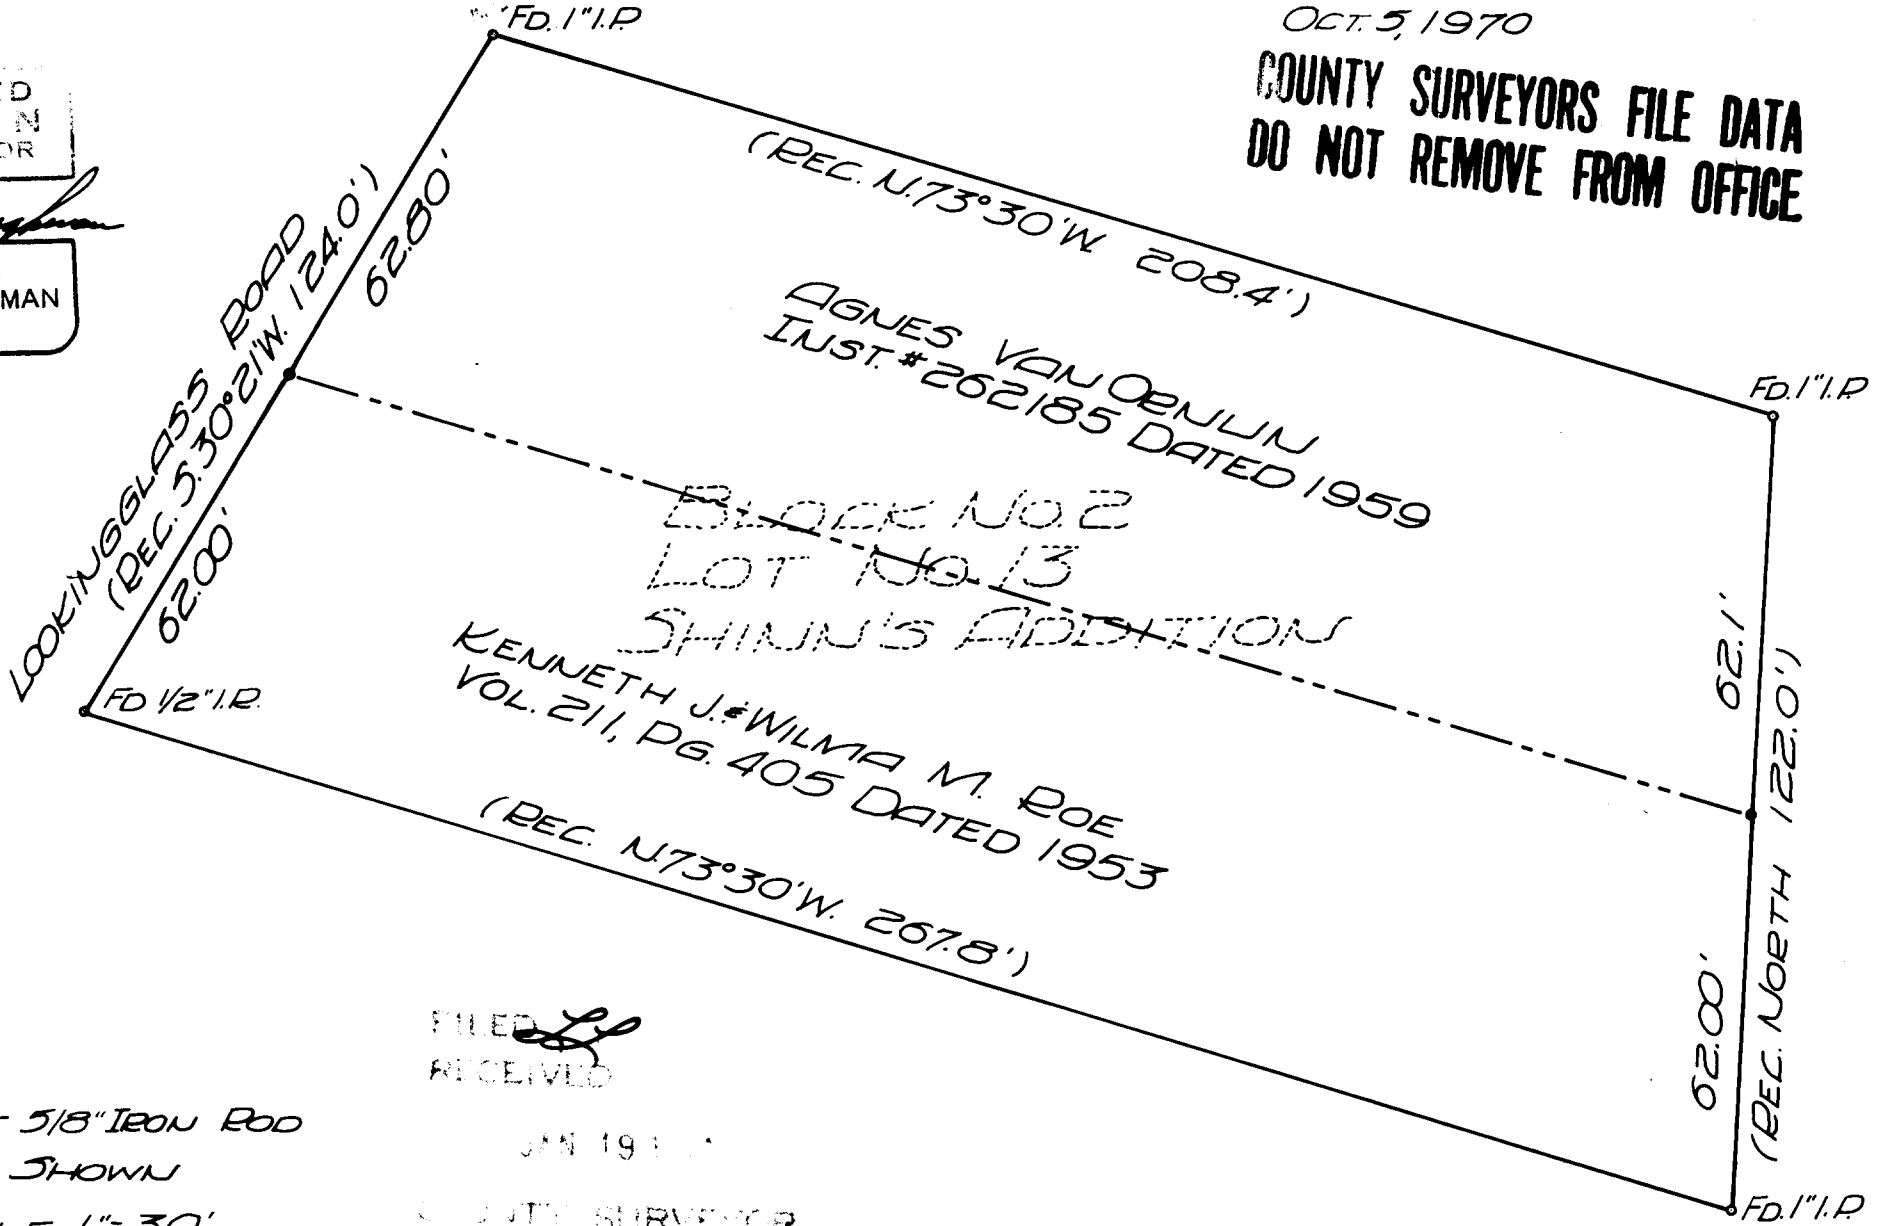

BEARINGS FROM SHINN'S ADDITION

FILED
RECEIVED

JAN 19 1971

COUNTY SURVEYOR
DOUGLAS COUNTY, ORE.

- SET 5/8" IRON ROD
 - AS SHOWN
- SCALE 1" = 30'