


COUNTY SURVEYORS FILE DATA
DO NOT REMOVE FROM OFFICE

SURVEY FOR DEED DESCRIPTION
IN THE N.W. 1/4 SEC 30, T. 30S, R. 5W. W.M.
FOR C. D. COLLINS
by BRUCE ROGERS
DEC., 1970
1" = 30'

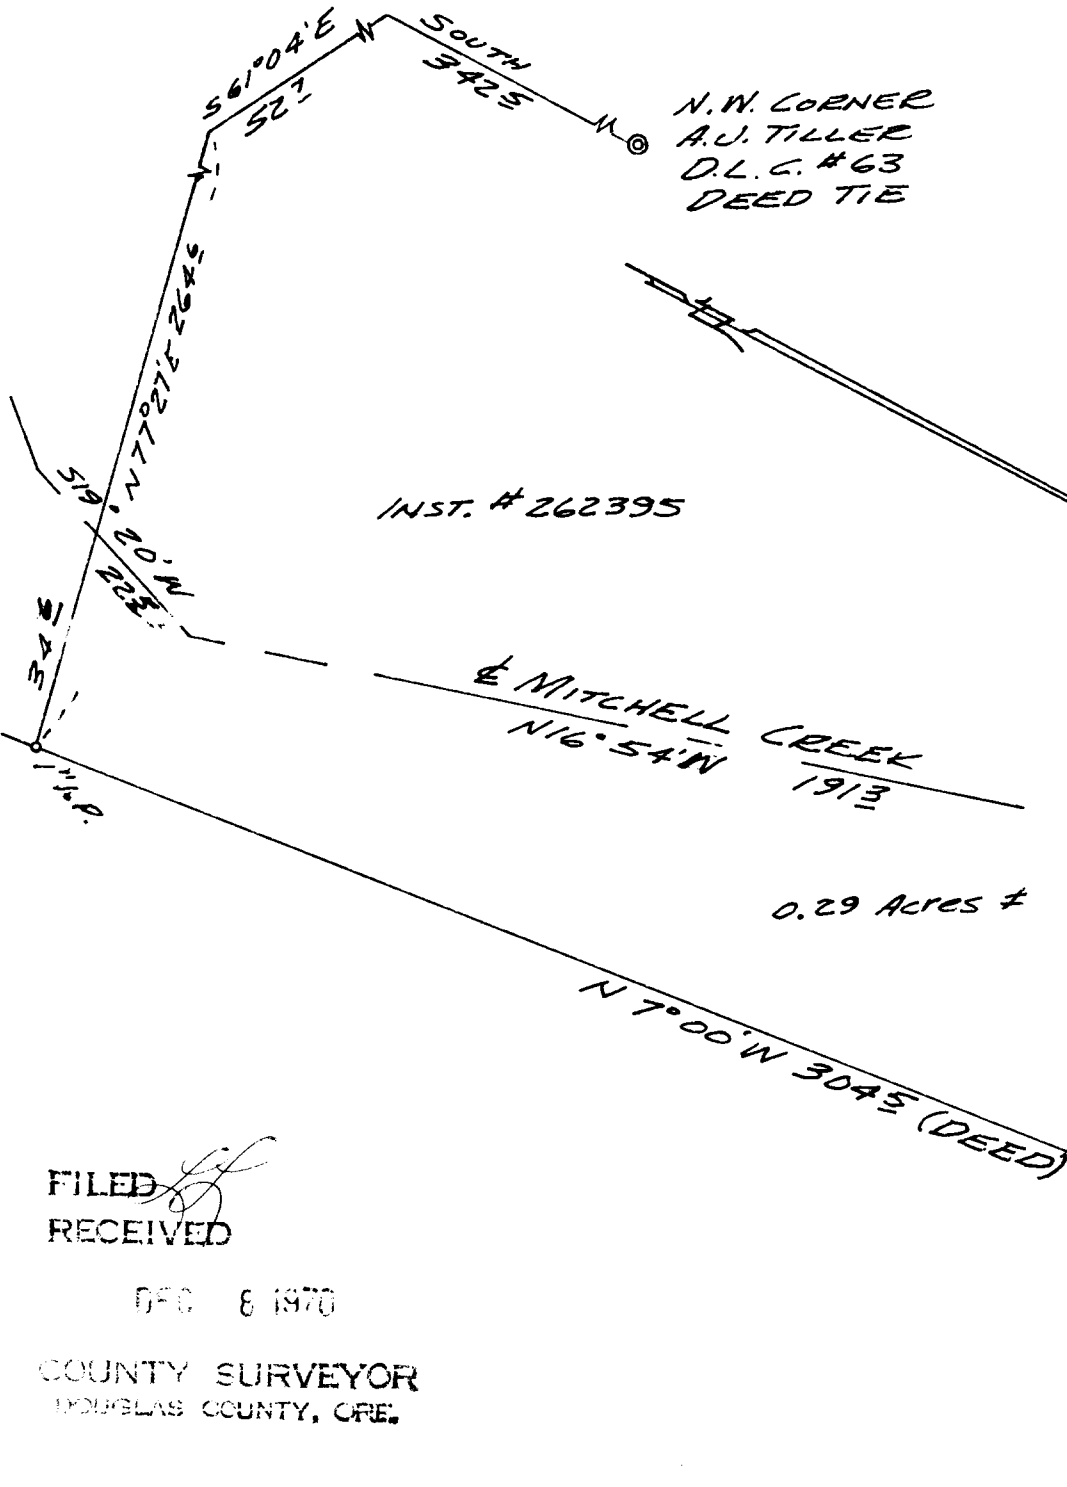

REGISTERED
OREGON
LAND SURVEYOR

Bruce R. Rogers

JULY 10, 1971
BRUCE R. ROGERS
660

FILED
RECEIVED

DEC 8 1970

COUNTY SURVEYOR
DOUGLAS COUNTY, ORE.

C.S. File No. 55/176-1