

**COUNTY SURVEYORS FILE DATA
DO NOT REMOVE FROM OFFICE**

SURVEY IN SEC. 4, T25S, R5W, W.M.

Surveyed for Jay R. Potter by Victor M. McLind
Feb. 1971

Scale: 1"=100'


o - Indicates Set $\frac{5}{8}$ " Iron Rod

N. $\frac{1}{4}$ Cor. Sec. 4, T25S, R5W, W.M.
Fd. Stone with $\frac{1}{4}$ "
38" Y Oak bears S20°W 192 ft.

FILED
RECEIVED

FEB 17 1971

COUNTY SURVEYOR
NICOLAAS COUNTY, ORE.

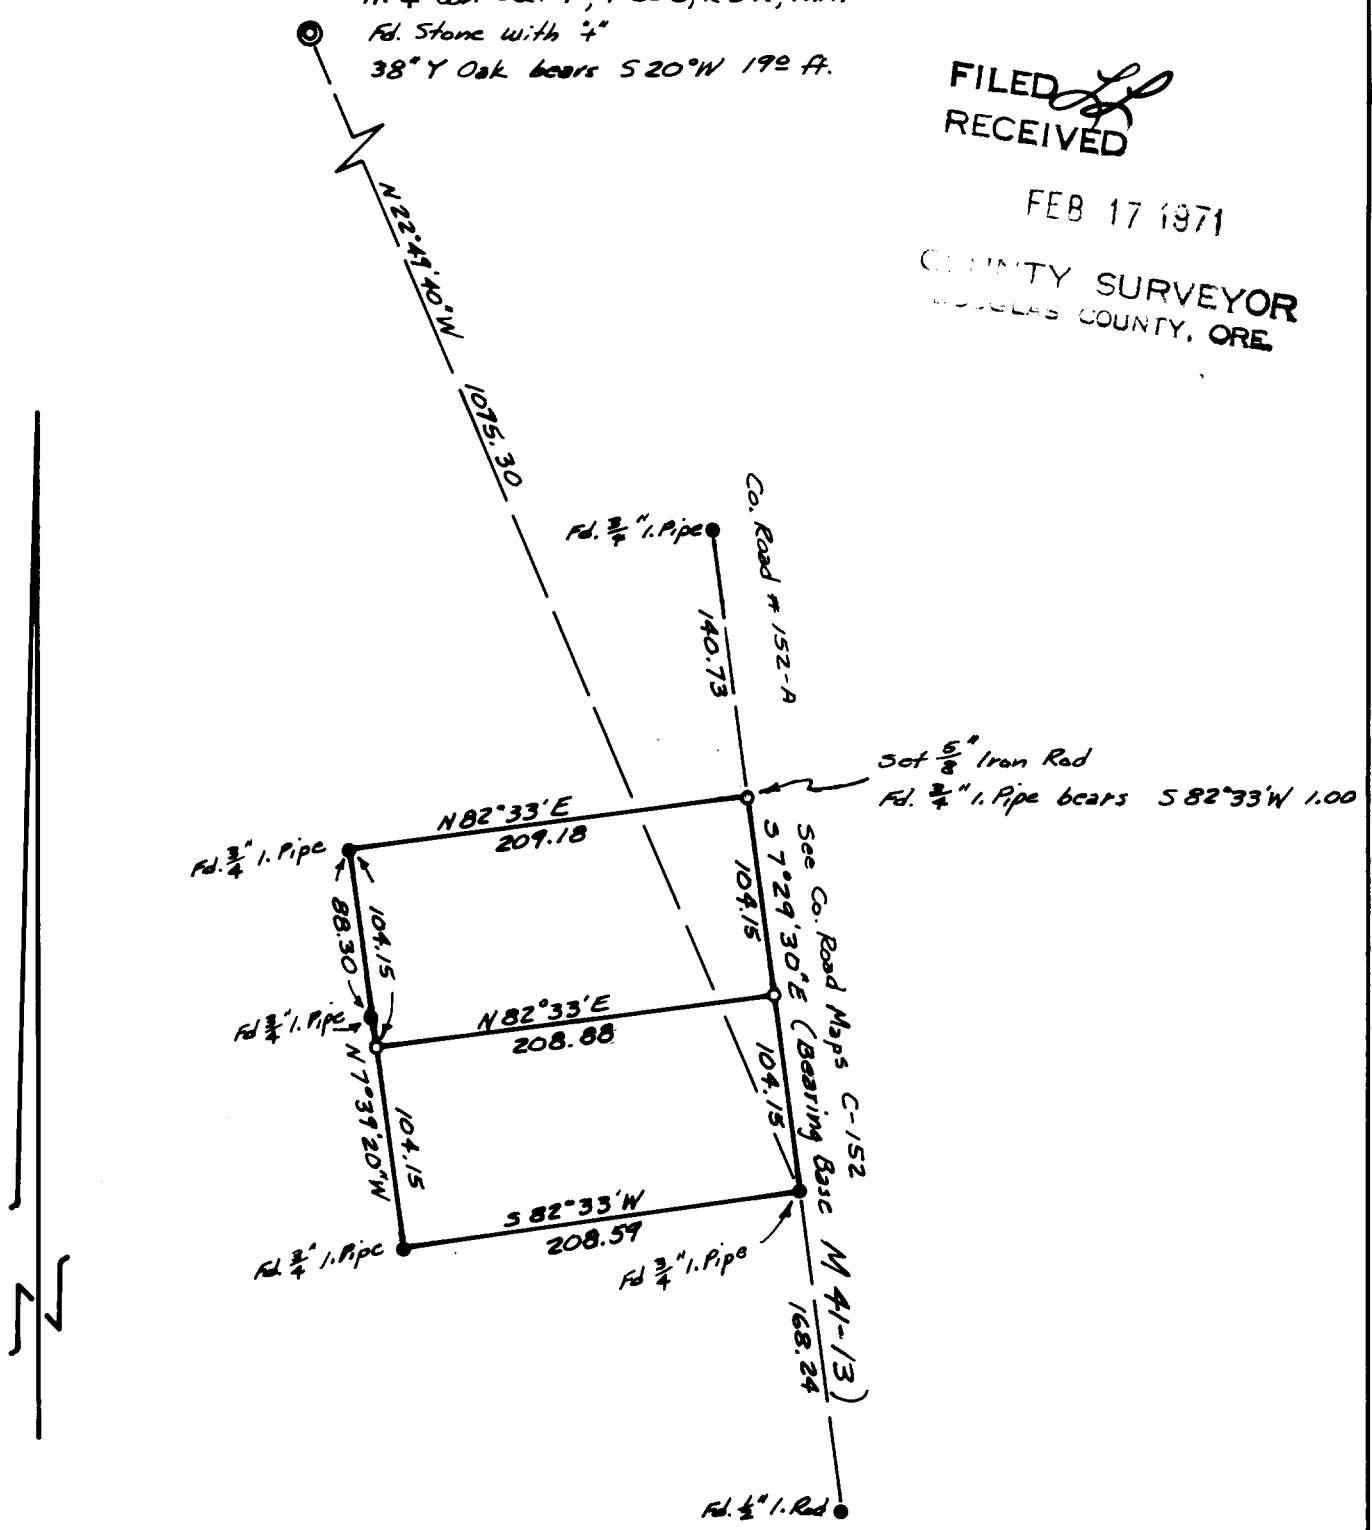

REGISTERED
OREGON
LAND SURVEYOR
Victor M. McLind
FEB 17 1971
VICTOR M. McLIND
934