



RESTORATION OF THE $\frac{1}{4}$ CORNER, Section 4 and 5, Township 20 South, Range 9 West, W.M.

True corner being a brass cap, established by the GLO, to be removed during road construction. From said corner I set a $1\frac{1}{2}$ " iron rod, bearing S. 65° W., 82.3 ft. From said iron rod, a second iron rod bearing N. 25° W. 25.8 ft. Both rods being witness points and both being $1\frac{1}{2}$ " in diameter. Said restoration being witness by Mr. T. Varley of Cottage Grove, Oregon.

February 11, 1971

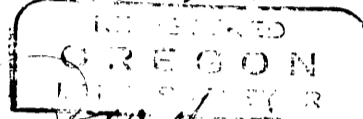

R. M. Morris

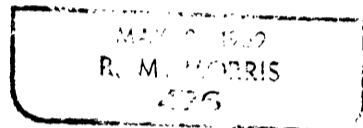

Dear Sir:

In regard to corner witnessed, as noted, will you be replacing the Brass Cap after the road is in or reestablishing a witness corner? Also, will you be marking bearing trees?

RM

FILED
RECEIVED

FEB 17 1971

COUNTY SURVEYOR
DOUGLAS COUNTY, ORE.

Mr. R. M. Morris
1125 Brackwood Ave.
McMinnville, Ore.

C.B. File 55/184

Sent to Thomas Varley
Delight Valley