


FILED  
RECEIVED

FEB 16 1971

COUNTY SURVEYOR  
DOUGLAS COUNTY, ORE.

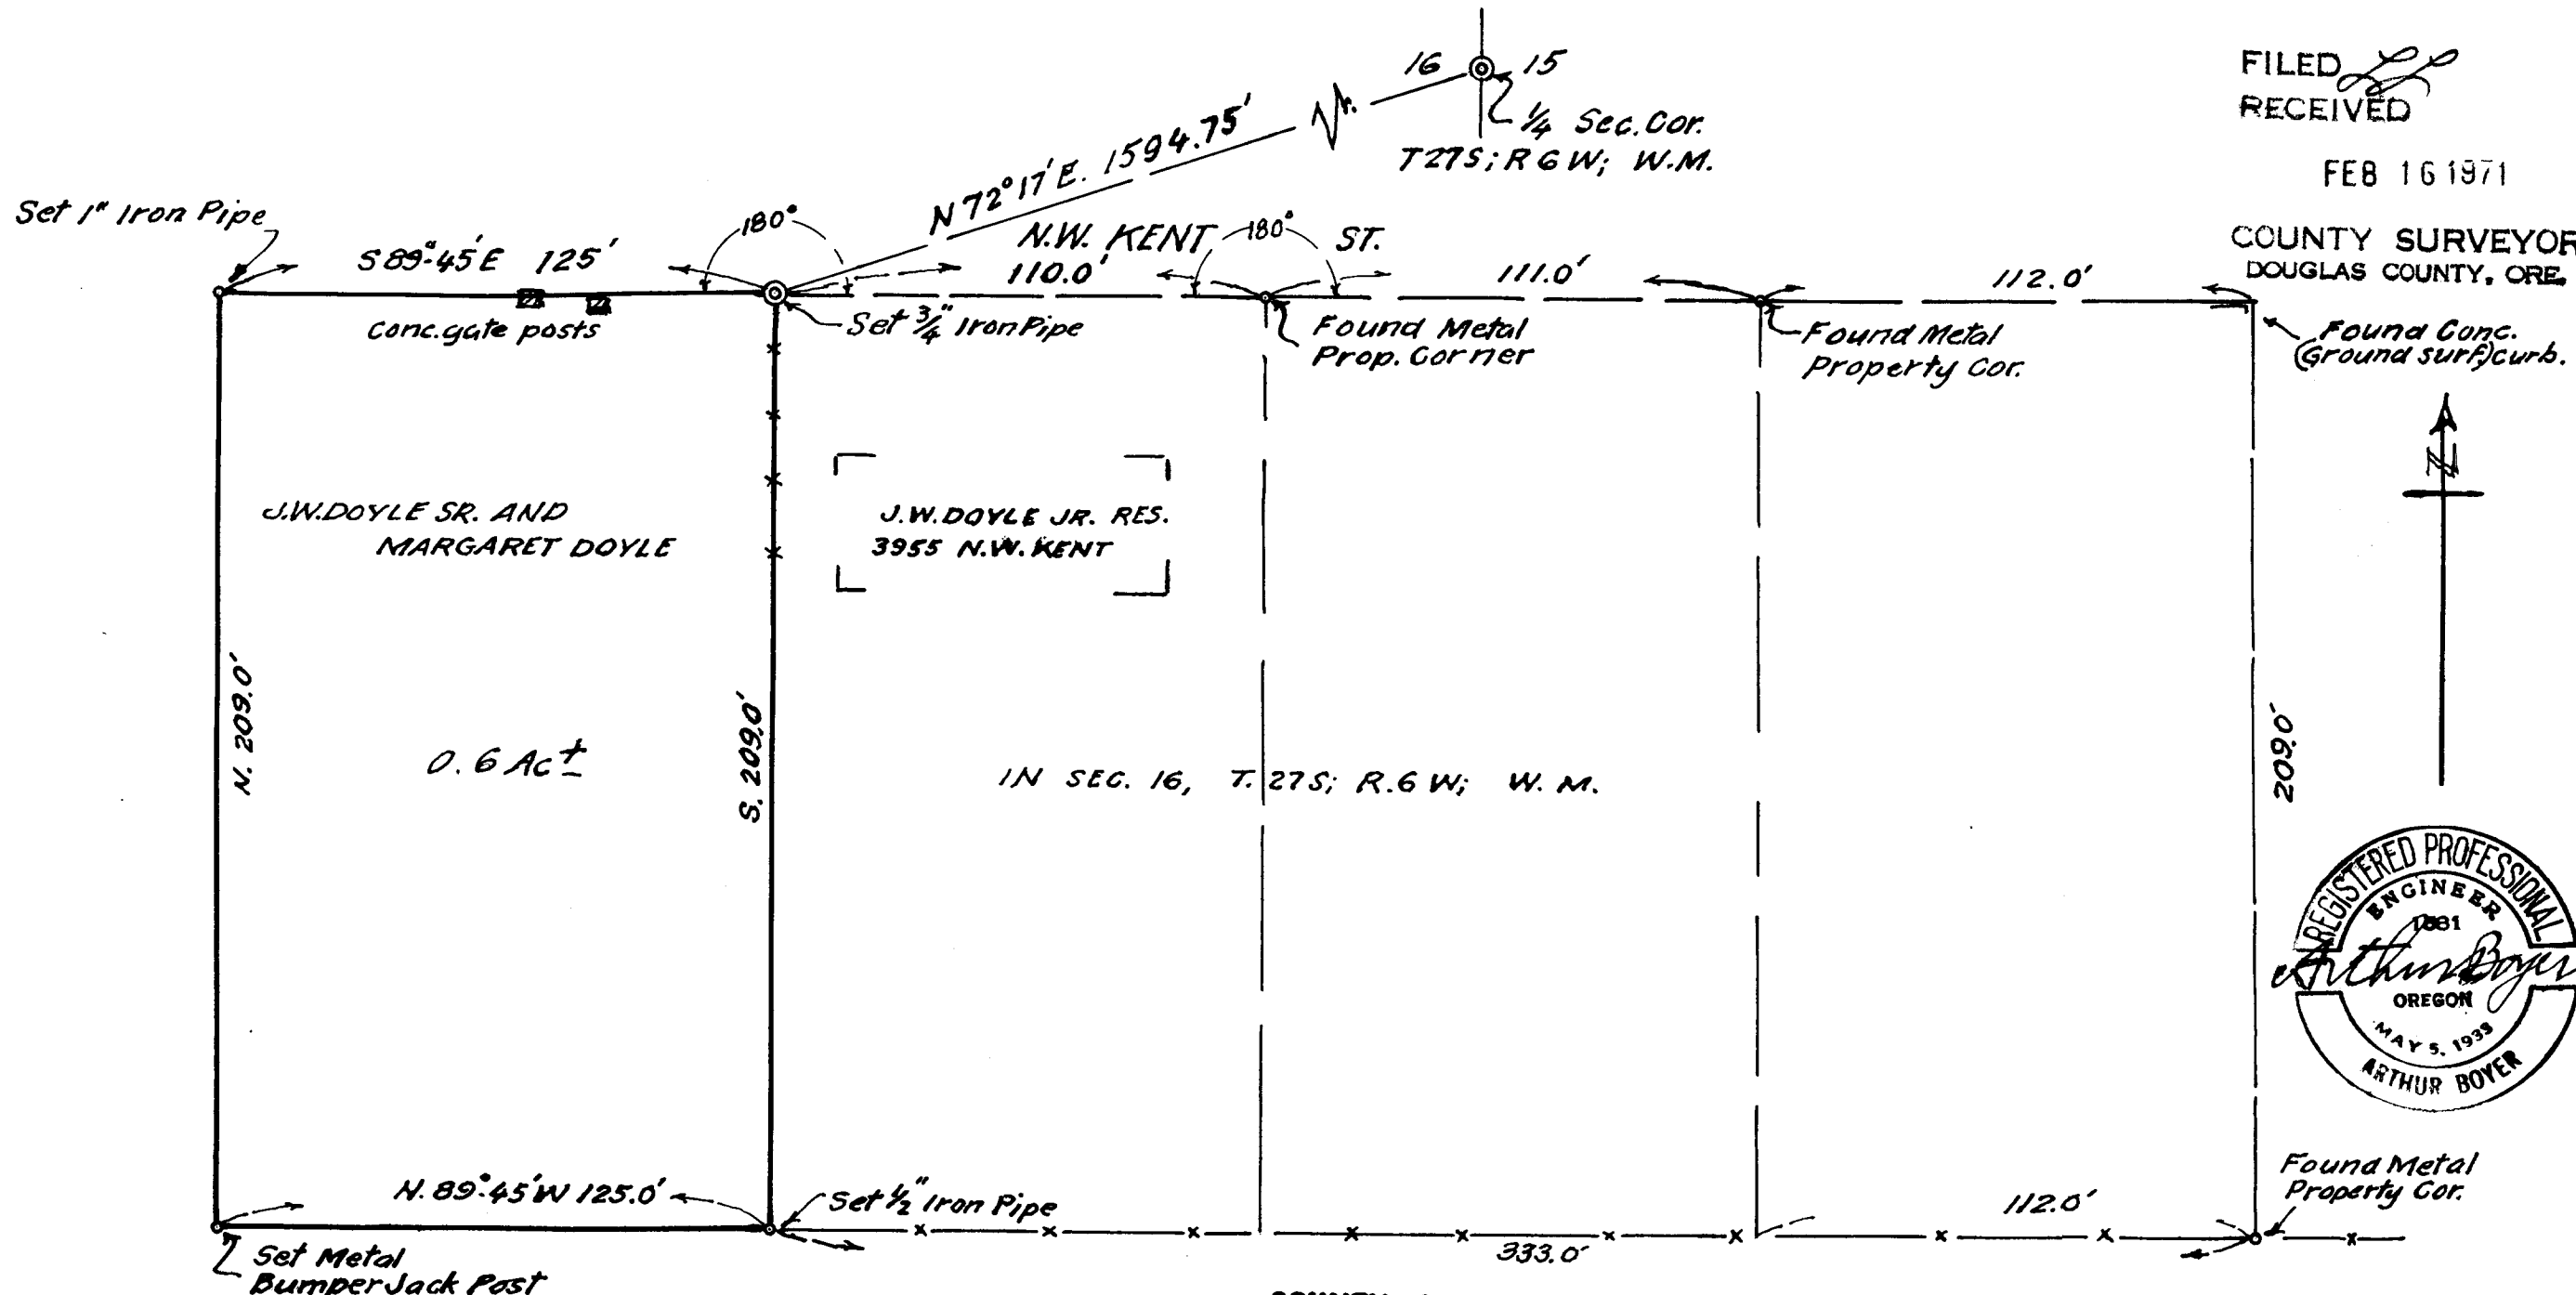

COUNTY SURVEYORS FILE DATA  
DO NOT REMOVE FROM OFFICE

J.W. DOYLE SR. & MARGARET DOYLE  
ACREAGE IN SEC. 16, T. 27S; R. 6W; W. M.;  
DOUGLAS COUNTY, ORE.  
Feb. 1971 1" = 40 ft.

SEE FILE