


**SURVEY FOR PROPERTY DESCRIPTION**  
**PORTION OF LOT 42 RIVER BEND ACRES PLAT A**  
**SURVEYED FOR ROBERT HERRELL**  
**SURVEYED BY ROBT H. GARNER**

MARCH, 1971  
 SCALE: 1"=100'

• - DENOTES SET 5/8" IRON ROD

**COUNTY SURVEYORS FILE DATA**  
**DO NOT REMOVE FROM OFFICE**

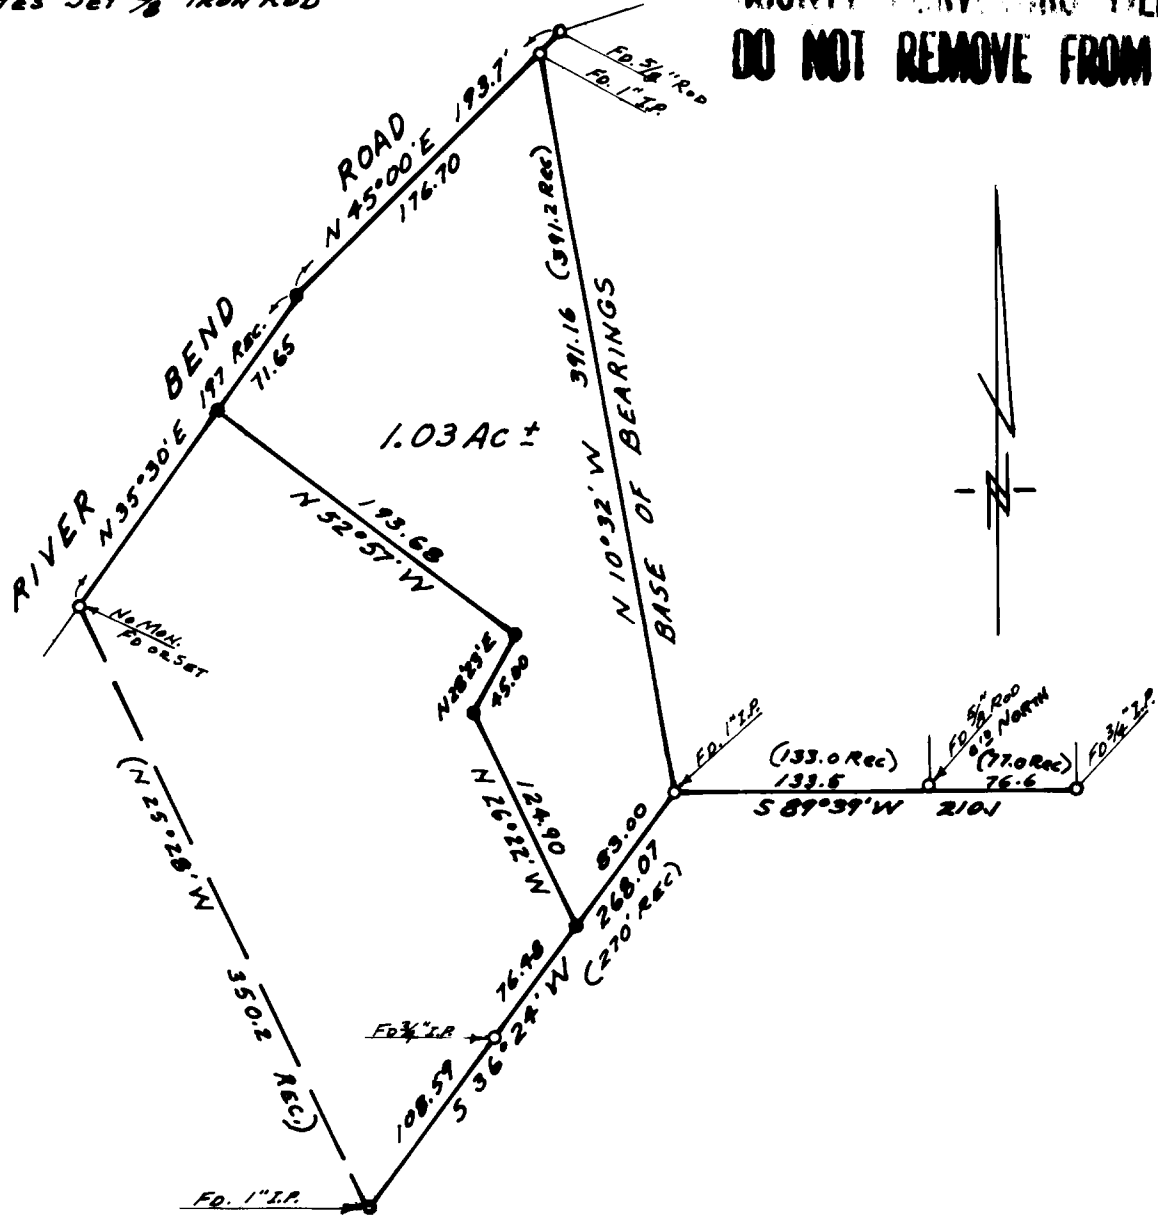

FILED  
 RECEIVED

MARCH 17 1971  
 COUNTY SURVEYOR  
 DOUGLAS COUNTY, OR

REGISTERED  
 OREGON  
 LAND SURVEYOR

*Robt H. Garner*

NOVEMBER 8 1965  
 ROBERT H. GARNER  
 724