


CERTIFIED RECORD OF LAND CORNER MONUMENTATION

✓

History of original corner establishment:

Never set

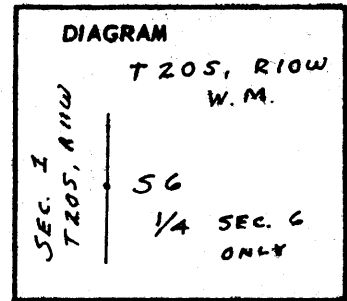


Description of corner evidence found:

None

Description of monument and accessories I established to perpetuate the original location of this corner

At the properly proportioned position I placed a 2" x 36" galvanized iron pipe, flanged at the bottom and capped with a bronze disk welded on top. The monument projects 6" above ground. I filled in around the pipe monument with stone and packed earth.

I stamped the disk

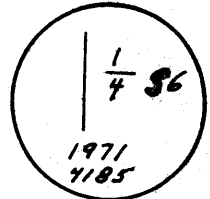

I established new bearing trees as follows. Each bearing tree has a scribed face and a U.S.F.S. bearing tree sign breast high and facing the monument.

Bearing trees set:

- a 28" fir bears N 40° E 24.1 feet
- a 20" fir bears N 24° E 34.6 feet

James W. [Signature]

Office of.....County..Surveyor..... County of.....Douglas.....

State of.....Oregon....., I hereby certify that the within instrument was filed in this office for record on the 24 day of.....June.....; 1971, at 11 o'clock A.m., (signed)

James W. [Signature] (COUNTY OFFICIAL) by (DEPUTY)

#46 T20-10W ✓
#99 T20-11W ✓

Form R6-7100-57 (9/66)

CORNER #12 ON MAP

C.S File 55/201-4

Map File M 41-77