


CERTIFIED RECORD OF LAND CORNER MONUMENTATION

History of original corner establishment:

Corner established in 1894 by General Land Office
Contract Survey

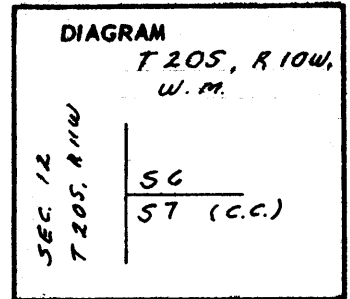

Original Survey record states: I set a ~~stone 10x8x8~~ 7 ins. in ground for closing corner to Sections 6 and 7 marked with CC and 5 notches on S and 1 notch on N faces and raised mound of stone 30 ins. high and 24 in base alongside. Pits impractical.

(No B.T.'s Set)


Description of corner evidence found:

None

Description of monument and accessories I established to perpetuate the original location of this corner

At the properly proportioned position I placed a 2" x 36" galvanized iron pipe, flanged at the bottom and capped with a bronze disk welded on top. The monument projects 6" above ground. I filled in around the pipe monument with stone and packed earth.

I stamped the disk

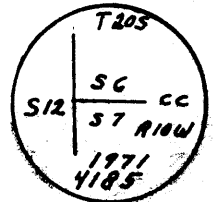

I established new bearing trees as follows. Each bearing tree has a scribed face and a U.S.F.S. bearing tree sign breast high and facing the monument.

Bearing trees set:

- a 16" fir bears N 60° E 72.25 feet
- an 18" fir bears S 49° E 47.59 feet

James W. [Signature]

Office of County Surveyor County of Douglas
 State of Oregon , I hereby certify that the within instrument was filed in this office
 for record on the 24 day of June; 1971, at 11 o'clock A.M., (signed)
James W. [Signature] by (DEPUTY)
 (COUNTY OFFICIAL)

#48 - T20-10 ✓
 #101 T20-11W ✓

CORNER #14 ON MAP

U.S. File 55/201-B

Map File M 4/77