


CERTIFIED RECORD OF LAND CORNER MONUMENTATION

History of original corner establishment:

Never set

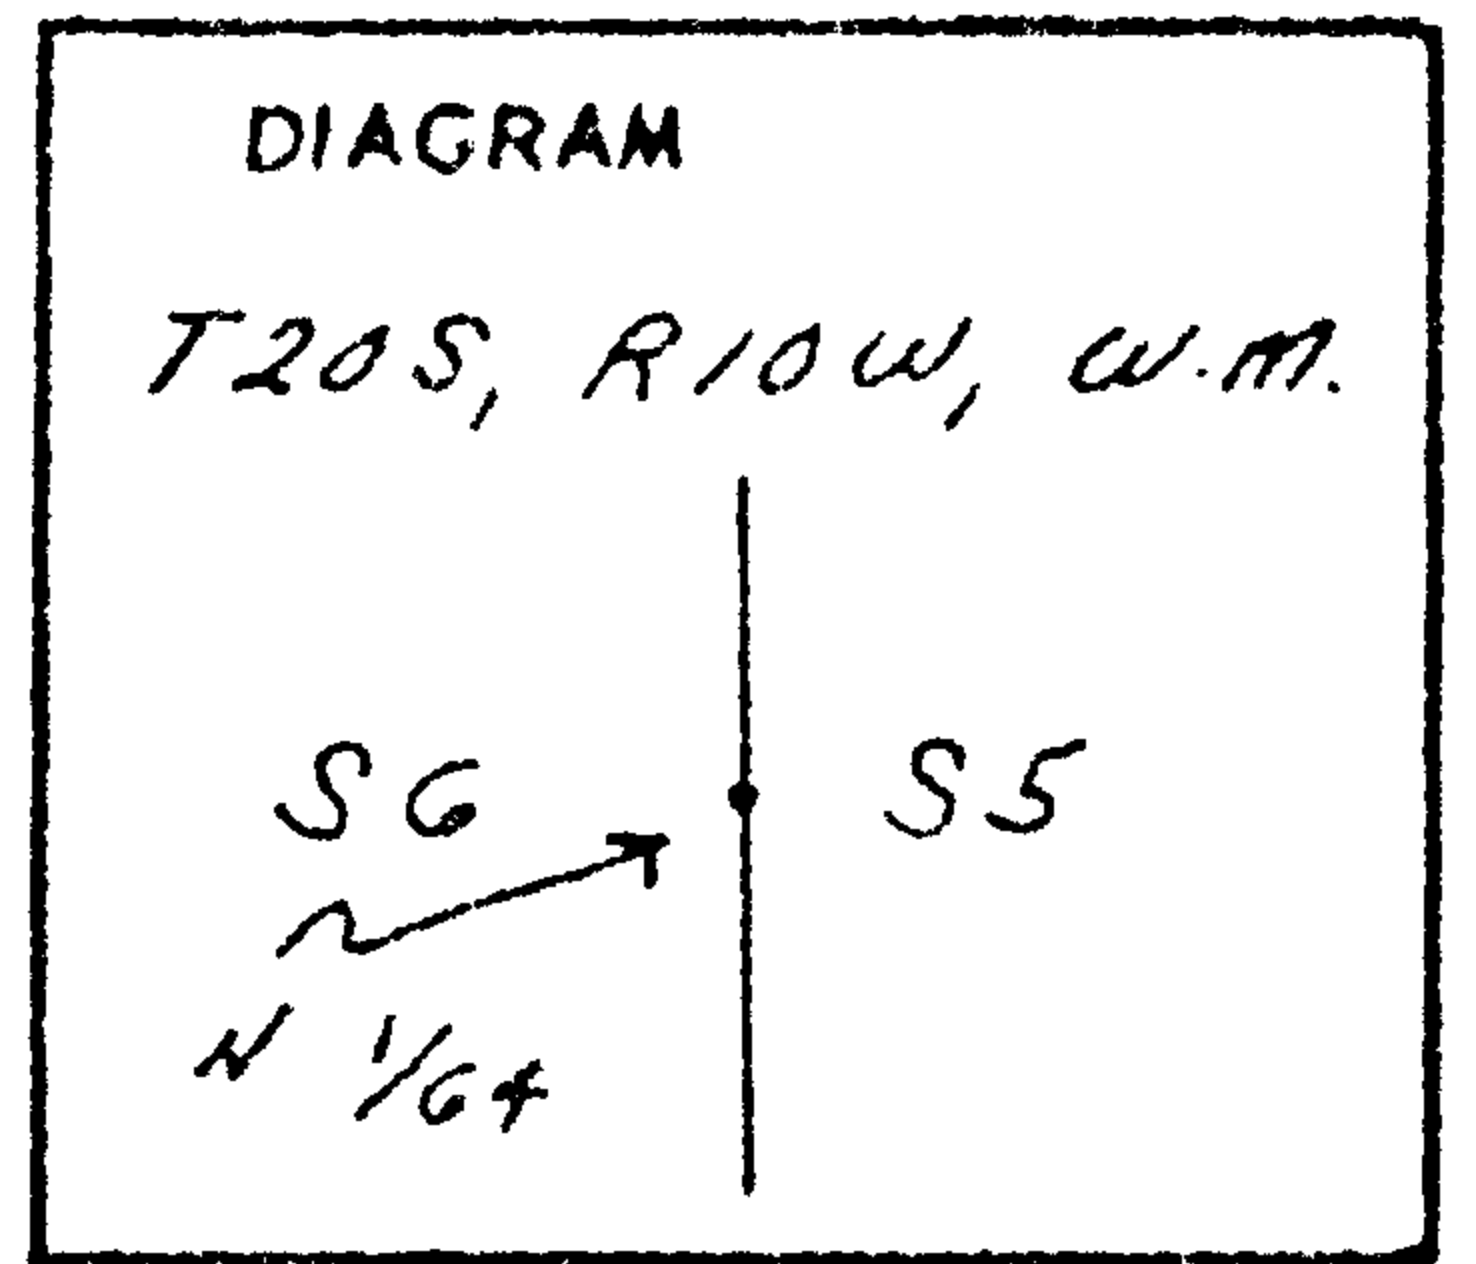


Description of corner evidence found:

None

Description of monument and accessories I established to perpetuate the original location of this corner

At the properly proportioned position I placed a 2" x 36" galvanized iron pipe, flanged at the bottom and capped with a bronze disk welded on top. The monument projects 6" above ground. I filled in around the pipe monument with stone and packed earth.

I stamped the disk

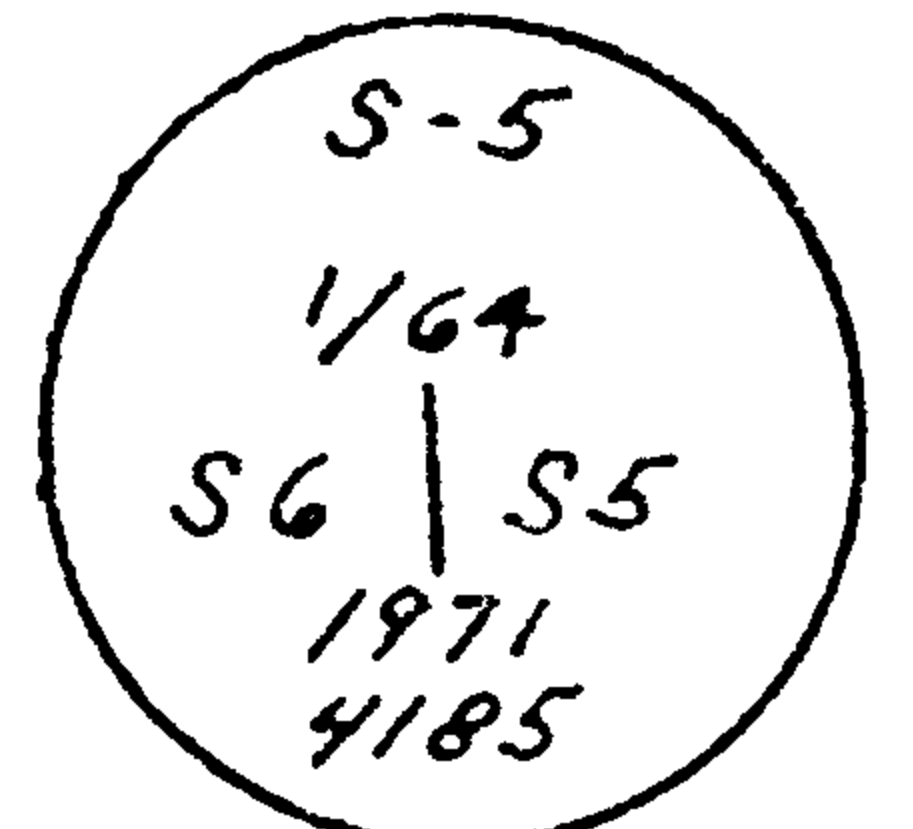

I established new bearing trees as follows. Each bearing tree has a scribed face and a U.S.F.S. bearing tree sign breast high and facing the monument.

Bearing trees set:


- a 18" fir bears S 5° E 27.84 feet
- a 14" fir bears N 25° W 20.1 feet

Office of..... County surveyor..... County of..... Douglas  
 State of..... Oregon....., I hereby certify that the within Instrument was filed in this office  
 for record on the... 12 day of... ~~Sept.~~ OCT... 19... 71, at... 10 o'clock A.m., (signed)  
*James W. Ryan* by..... (COUNTY OFFICIAL)..... (DEPUTY)

**CERTIFIED RECORD OF LAND CORNER MONUMENTATION**

History of original corner establishment:

Never set

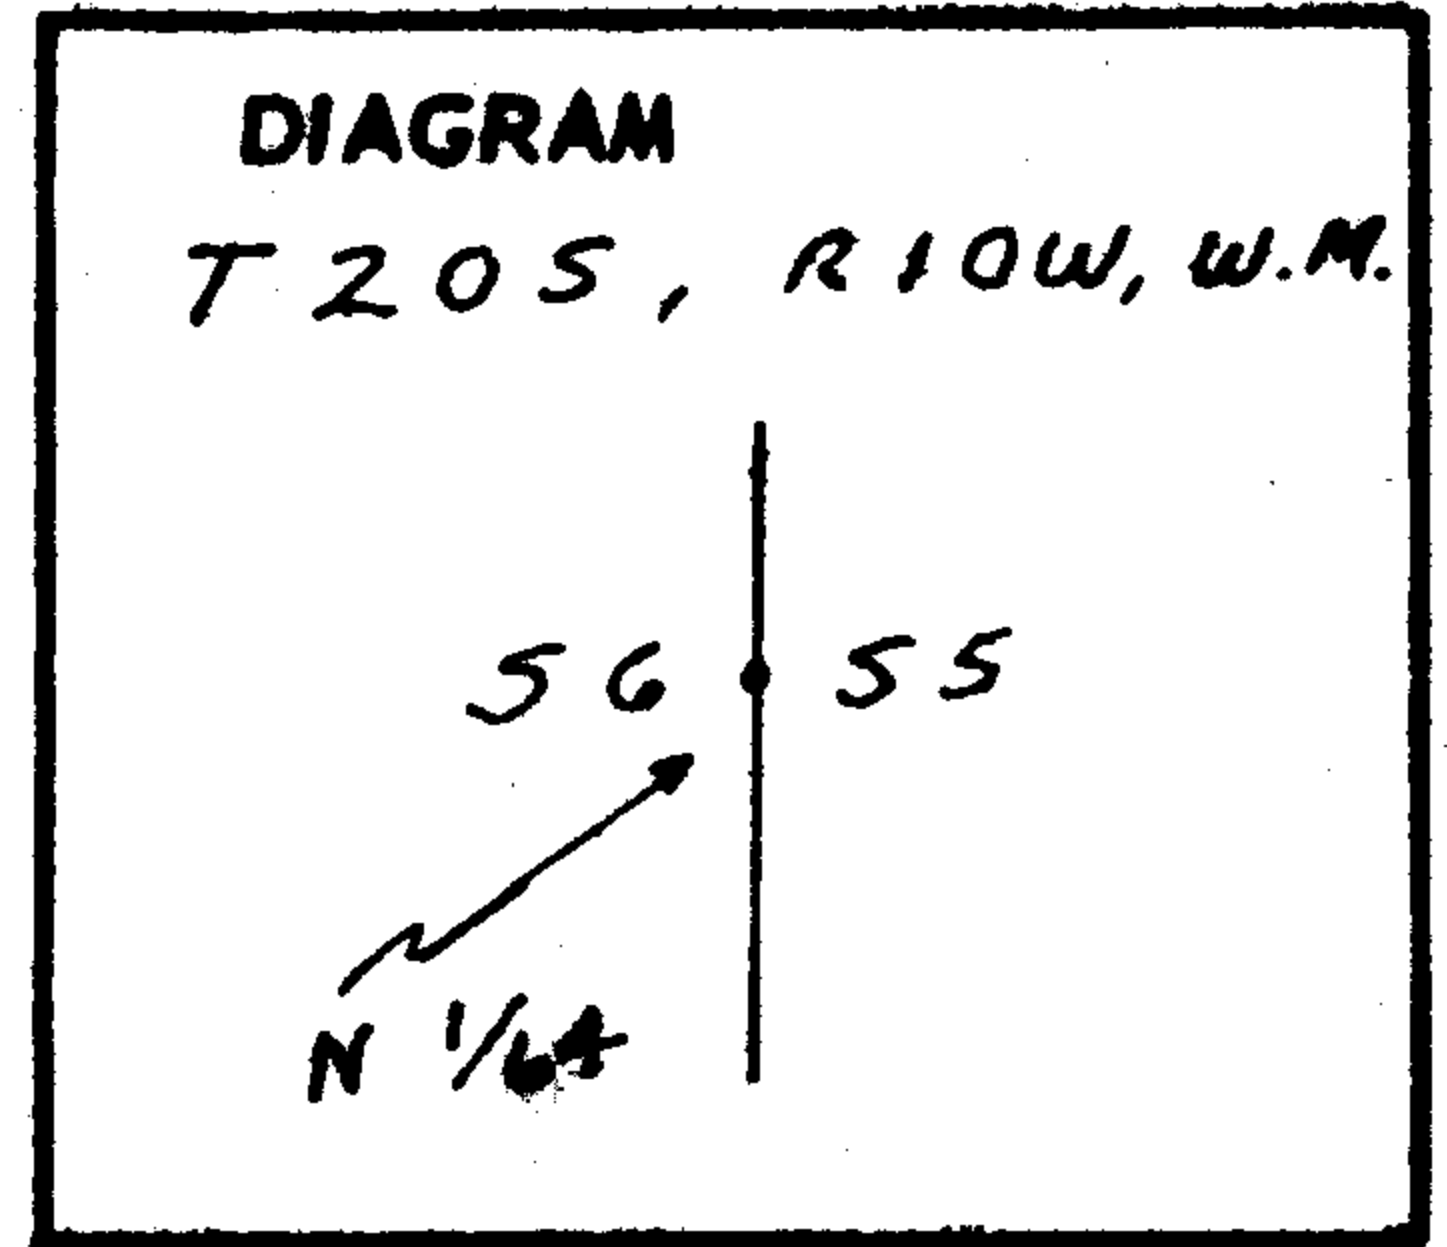


Description of corner evidence found:

None

SEE NEW NOTES  
10/12/71

Description of monument and accessories I established to perpetuate the original location of this corner

At the properly proportioned position I placed a 2" x 36" galvanized iron pipe, flanged at the bottom and capped with a bronze disk welded on top. The monument projects 6" above ground. I filled in around the pipe monument with stone and packed earth.

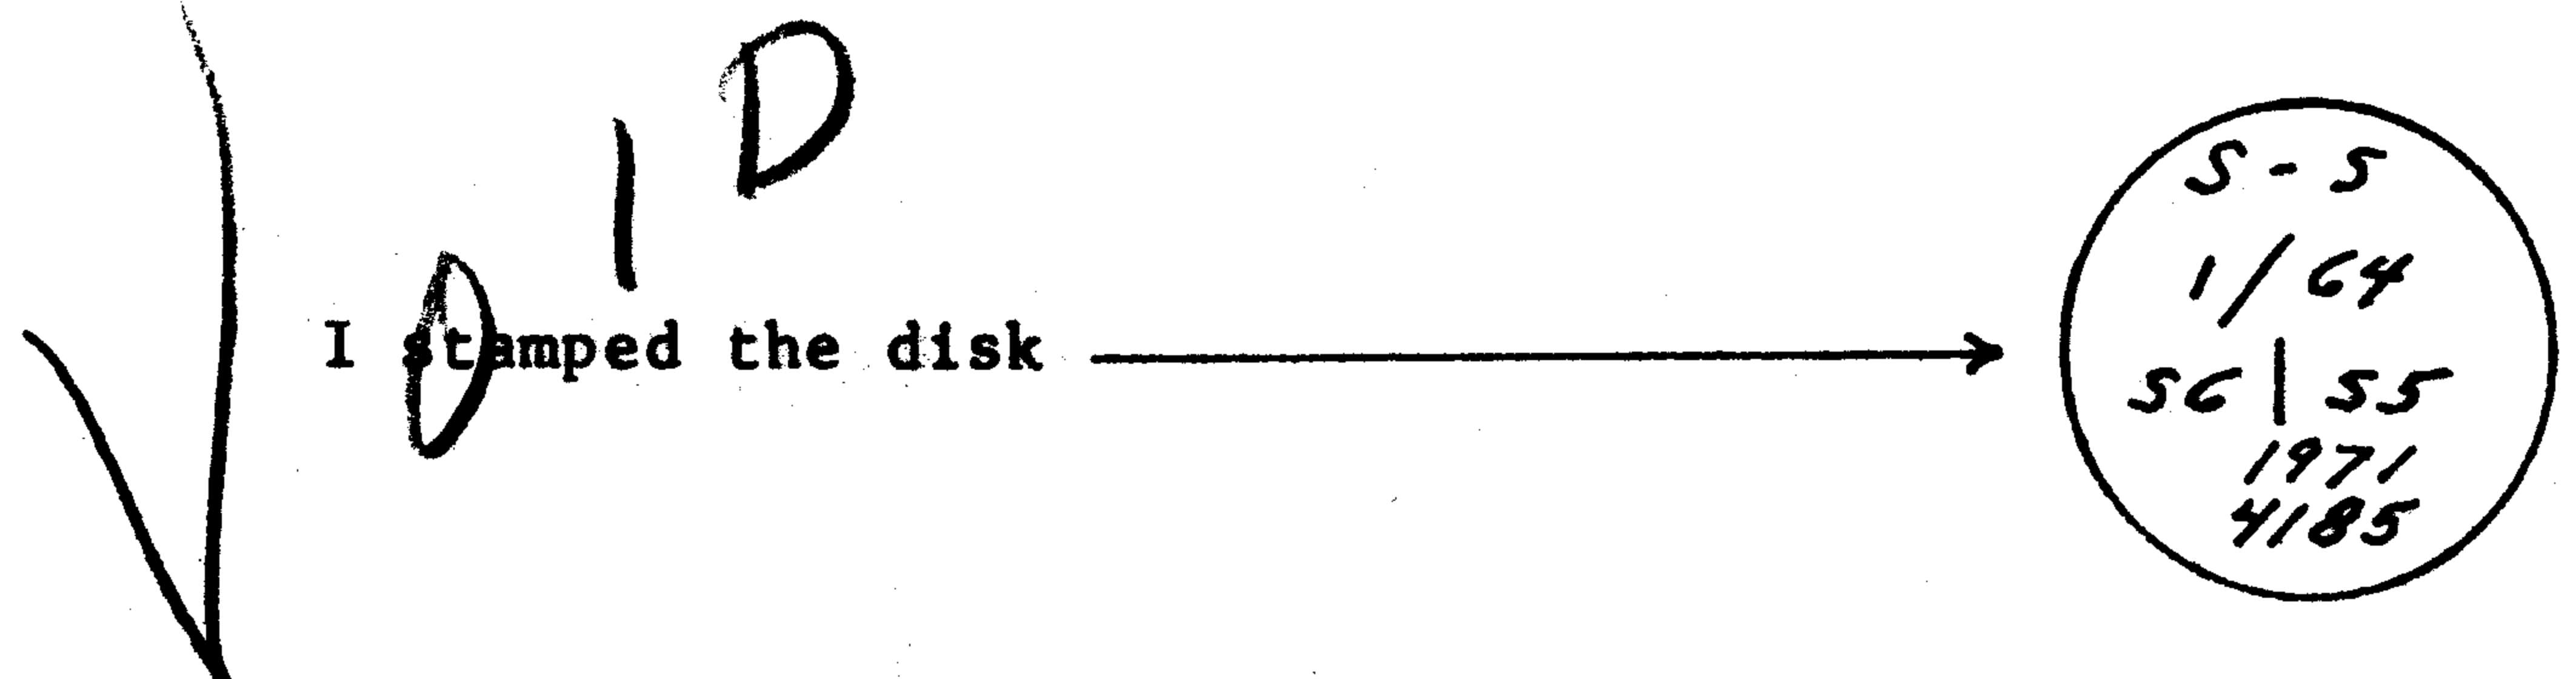

I established new bearing trees as follows. Each bearing tree has a scribed face and a U.S.F.S. bearing tree sign breast high and facing the monument.

Bearing trees set:

- a 28" fir bears S 10° W 17.87 feet
- an 18" fir bears S 80° E 6.33 feet

*James W. Fink*

Office of County Surveyor County of Douglas  
 State of OREGON, I hereby certify that the within instrument was filed in this office  
 for record on the 24 day of June, 1971, at 11 o'clock A.m., (signed)  
*James W. Fink* by \_\_\_\_\_ (DEPUTY)  
 (COUNTY OFFICIAL)