


CERTIFIED RECORD OF LAND CORNER MONUMENTATION

✓

History of original corner establishment:

Never set

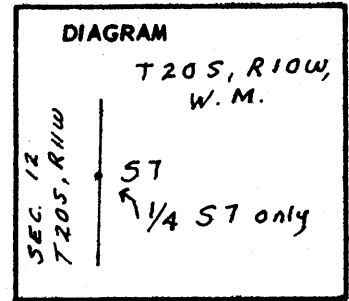


Description of corner evidence found:

None

Description of monument and accessories I established to perpetuate the original location of this corner

At the properly proportioned position I placed a 2" x 36" galvanized iron pipe, flanged at the bottom and capped with a bronze disk welded on top. The monument projects 6" above ground. I filled in around the pipe monument with stone and packed earth.

I stamped the disk

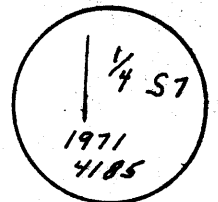

I established new bearing trees as follows. Each bearing tree has a scribed face and a U.S.F.S. bearing tree sign breast high and facing the monument.

Bearing trees set:

- a 22" fir bears N 29° E 49.4 feet
- a 14" fir bears N 78° E 75.54 feet

*James W. [Signature]*

Office of ..... County Surveyor ..... County of ..... Douglas .....  
 State of ..... Oregon ..... , I hereby certify that the within instrument was filed in this office  
 for record on the ... 24 day of ..... June .....; 1971, at ... 11 o'clock A.M., (signed)  
*James W. [Signature]* by .....  
 (COUNTY OFFICIAL) (DEPUTY)

CORNER #11 ON MAP

#50 T20-10W ✓  
#103 T20-11W ✓

C.S. File 55/201-11

Form R6-7100-57 (9/66)

Map File M 44-77