


CERTIFIED RECORD OF LAND CORNER MONUMENTATION

History of original corner establishment:

Never set

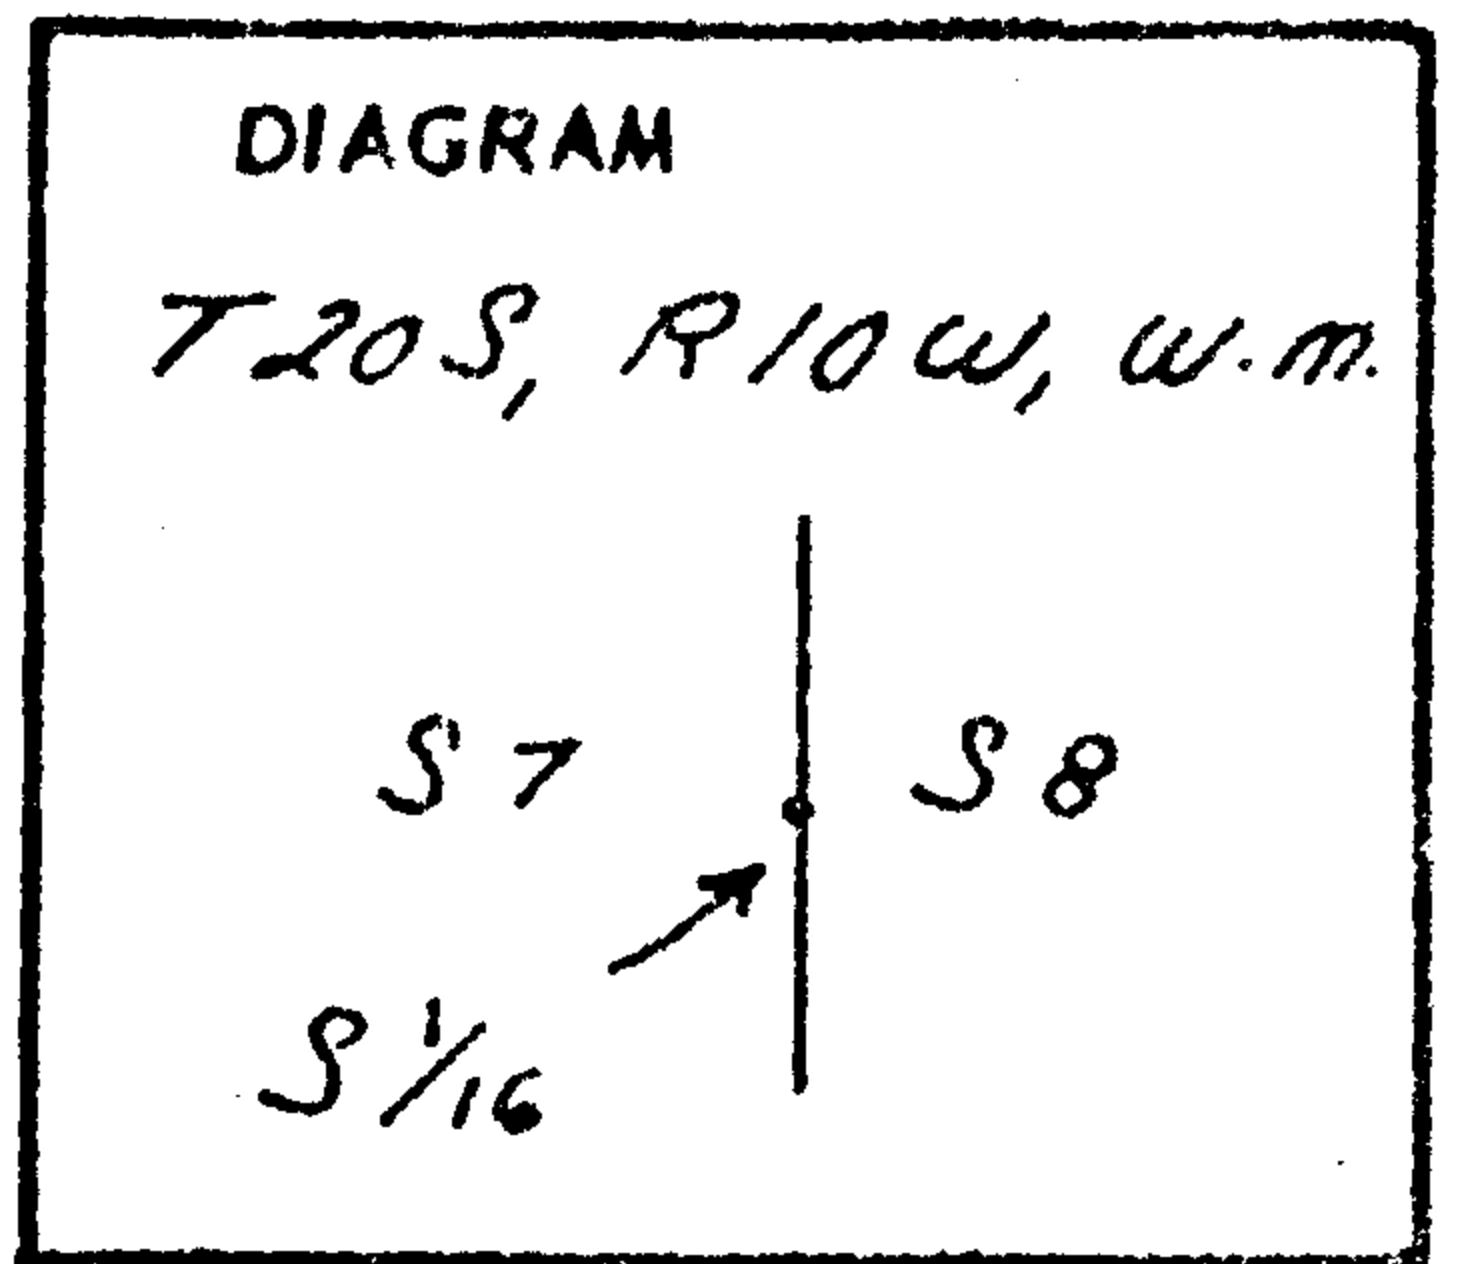


Description of corner evidence found:

None

Description of monument and accessories I established to perpetuate the original location of this corner

At the properly proportioned position I placed a 2" x 36" galvanized iron pipe, flanged at the bottom and capped with a bronze disk welded on top. The monument projects 6" above ground. I filled in around the pipe monument with stone and packed earth.

I stamped the disk

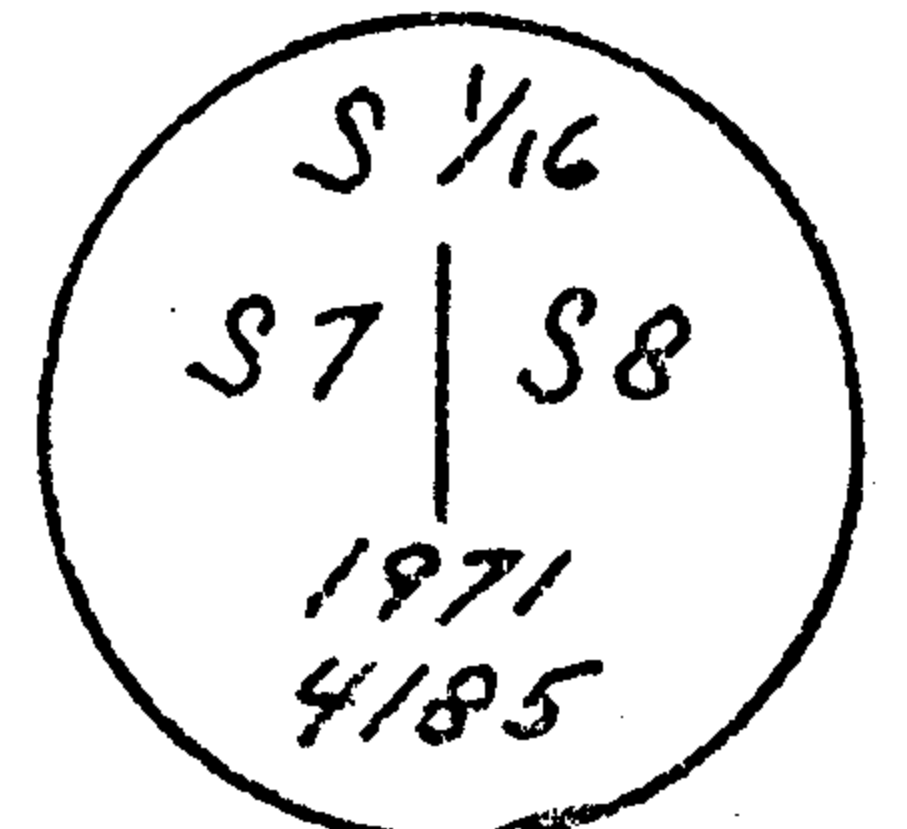

I established new bearing trees as follows. Each bearing tree has a scribed face and a U.S.F.S. bearing tree sign breast high and facing the monument.

Bearing trees set:

- a 16" fir bears N 39° W 40.3 feet
- a 12" maple bears N 56° E 45.7 feet


Office of County Surveyor County of Douglas
 State of Oregon, I hereby certify that the within instrument was filed in this office
 for record on the 12 day of Sept.; 1971, at 10 o'clock A.m., (signed)
James W. Ryan by _____
 (COUNTY OFFICIAL) (DEPUTY)

James W. Ryan

CERTIFIED RECORD OF LAND CORNER MONUMENTATION

History of original corner establishment:

Never set

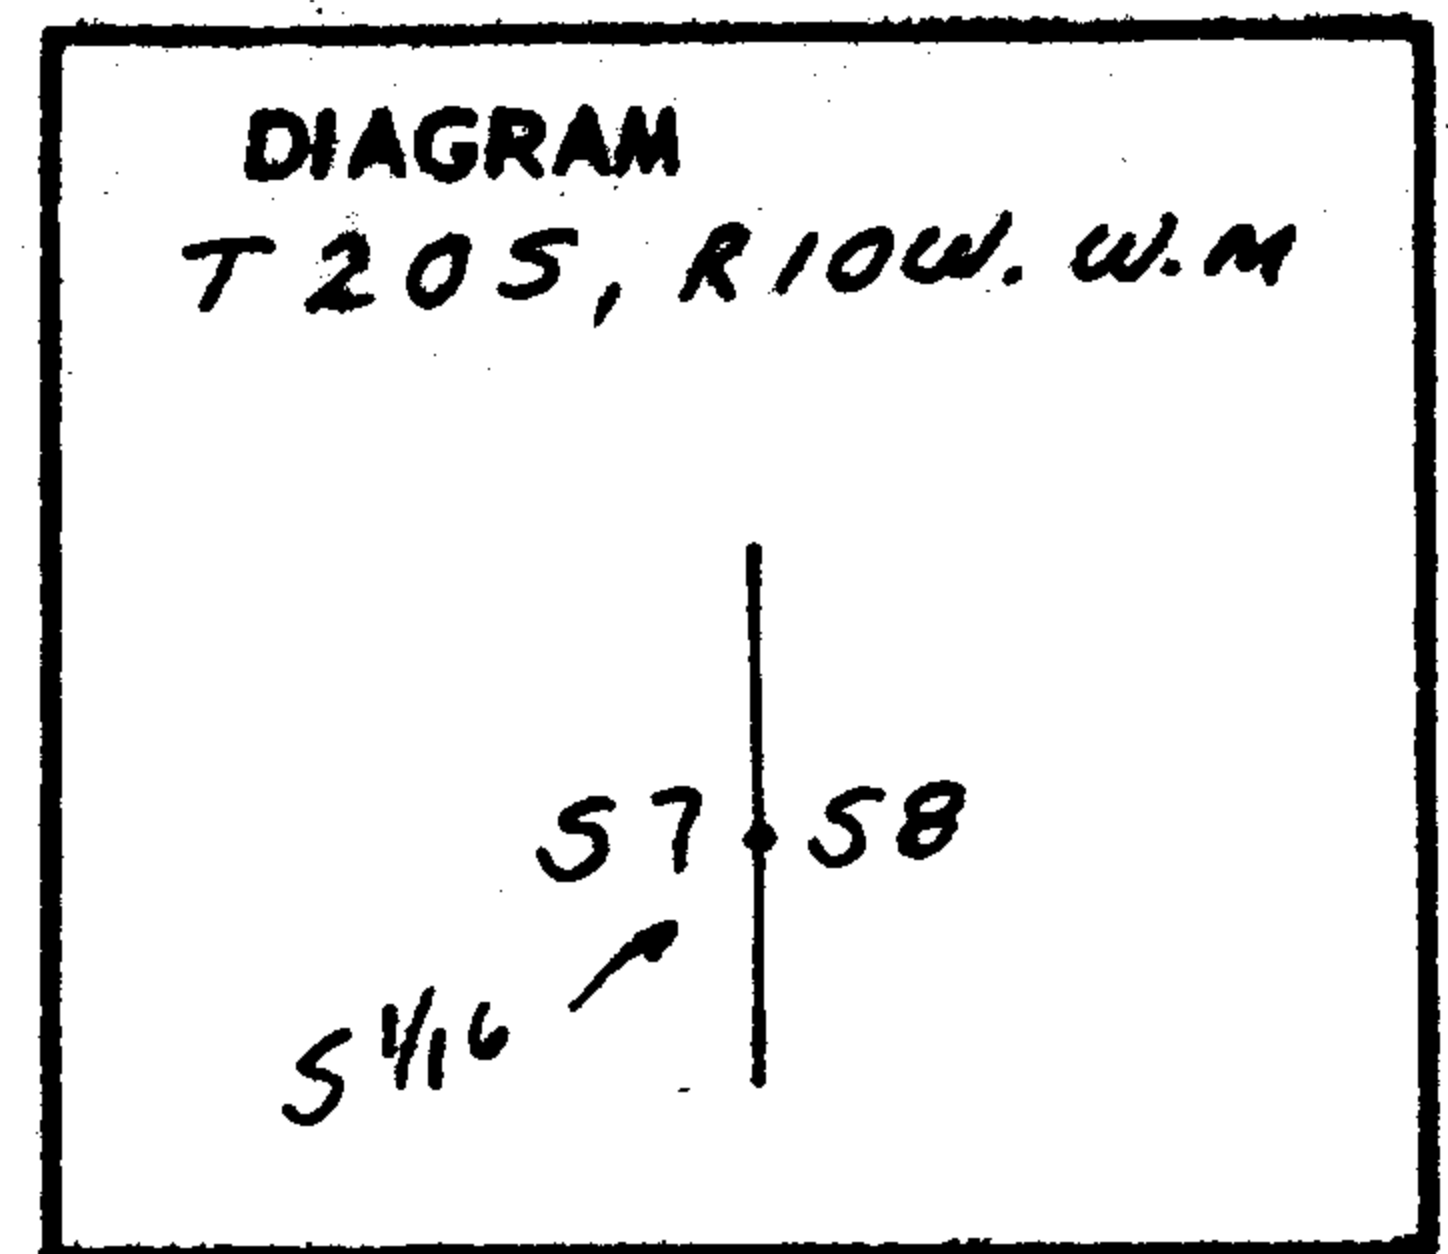


Description of corner evidence found:

None

SEE NEW NOTES
10/12/71

Description of monument and accessories I established to perpetuate the original location of this corner

At the properly proportioned position I placed a 2" x 36" galvanized iron pipe, flanged at the bottom and capped with a bronze disk welded on top. The monument projects 6" above ground. I filled in around the pipe monument with stone and packed earth.

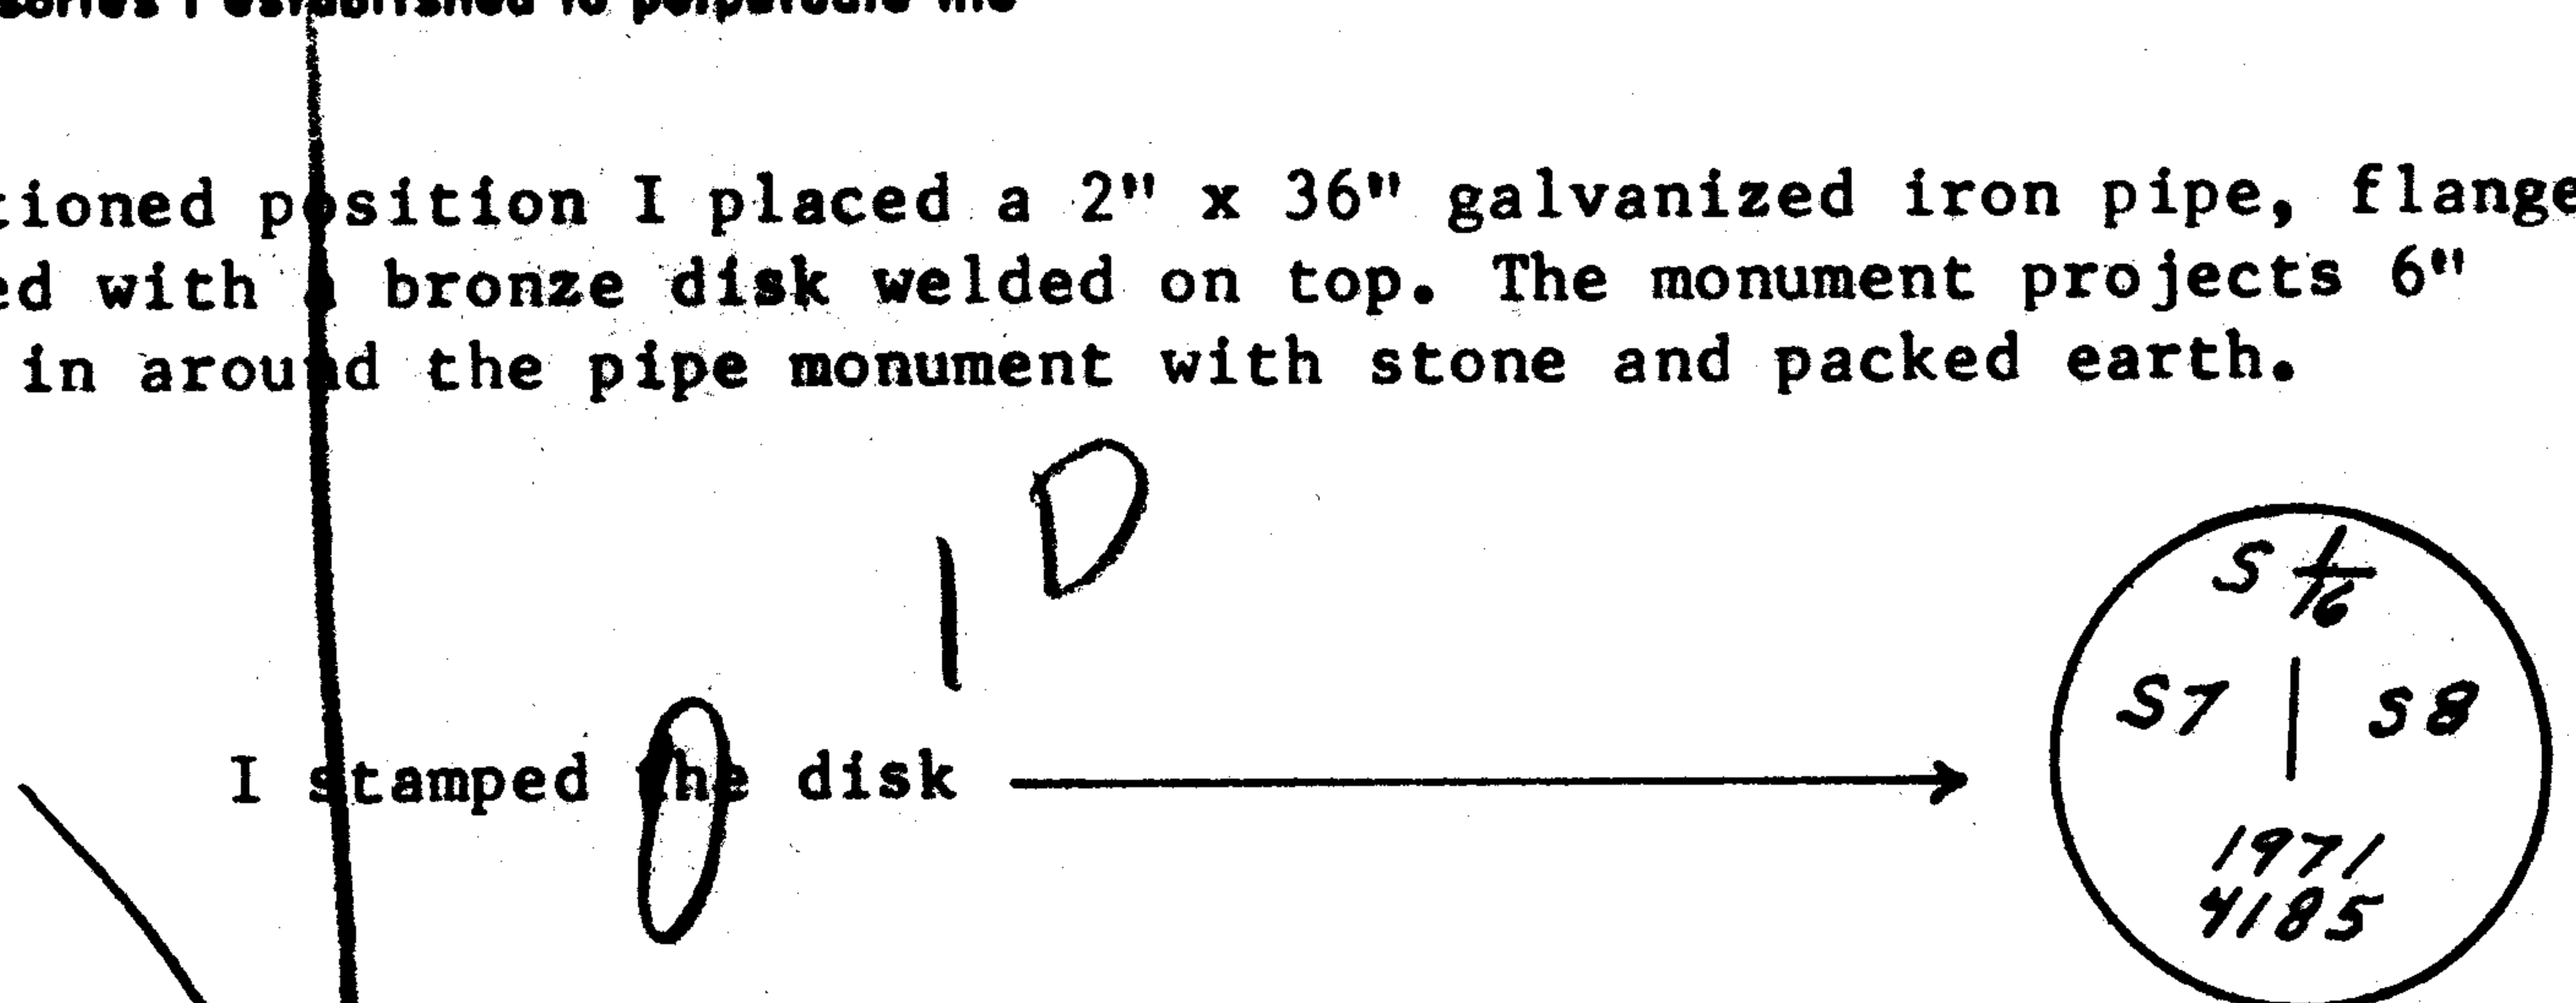

I established new bearing trees as follows. Each bearing tree has a scribed face and a U.S.F.S. bearing tree sign breast high and facing the monument.

Bearing trees set:

- a 10" yew bears S 89° W 84.80 feet
- a 10" maple bears S 83° E 37.80 feet

James W. Anderson

Office of County Surveyor County of Douglas
 State of Oregon , I hereby certify that the within instrument was filed in this office
 for record on the 24 day of June 1971, at o'clock A.M., (signed)
 by
 (COUNTY OFFICIAL) (DEPUTY)

✓