


CERTIFIED RECORD OF LAND CORNER MONUMENTATION

History of original corner establishment:

Corner established in 1892 by General Land Office

Contract Survey

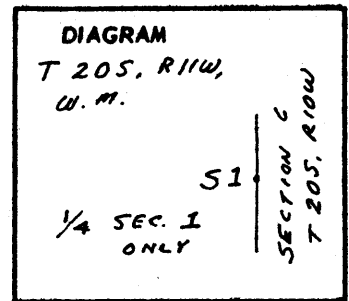

Original survey record states: Set a sandstone 12X8X7 8 ins. in the ground for 1/4 sec. cor. marked 1/4 on W. face, from which:

- a fir 6 ins. in dia. bears S 11° E 90 lks. dist., marked 1/4 S B.T.
- a fir 5 ins. in dia. bears N 87° W 75 lks. dist., marked 1/4 S B.T.

1894 survey makes corner common to Section 1 only


Description of corner evidence found:

None

Description of monument and accessories I established to perpetuate the original location of this corner

At the properly proportioned position I placed a 2" x 36" galvanized iron pipe, flanged at the bottom and capped with a bronze disk welded on top. The monument projects 6" above ground. I filled in around the pipe monument with stone and packed earth.

I stamped the disk

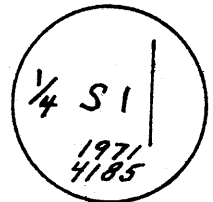

I established new bearing trees as follows. Each bearing tree has a scribed face and a U.S.F.S. bearing tree sign breast high and facing the monument.

Bearing trees set:

- a 16" fir bears N 82° W 31.00 feet
- an 18" fir bears N 57° W 42.18 feet

James W. [Signature]

Office of County Surveyor County of Douglas
 State of Oregon , I hereby certify that the within instrument was filed in this office
 for record on the 24 day of June 1971, at 11 o'clock A.M., (signed)
 [Signature] by
 (COUNTY OFFICIAL) (DEPUTY)

CORNER #11 ON MAP

C.S. File 55 / 201-15

Map File M 41 P 77

#45 - T20-10 ✓
#98 - T20-11 ✓