

CERTIFIED RECORD OF LAND CORNER MONUMENTATION

History of original corner establishment:

Corner established in 1892 by General Land Office

Contract Survey


Original Survey record states: Set a post 4½ ft. long 24 ins. in the ground from which:

- a maple 8" dia. bears N 45° E 30 lks. dist.
- a maple 24" dia. bears S 89° E 30 lks. dist.
- an alder 4" dia. bears S 64° W 117 lks. dist.
- a fir 4" diam. bears N 21° W 47 lks. dist.

Note: In 1894 all markings relating to R10W were destroyed making corner common to Sections 1 & 12 only

Description of corner evidence found:

Found original maple B.T. in NE quadrant (Good face but scribing was destroyed in 1894) Found fir B.T. now 30" windfall with faint face on bottom. Corner agrees very well with " canon " call 0.25 chains North.

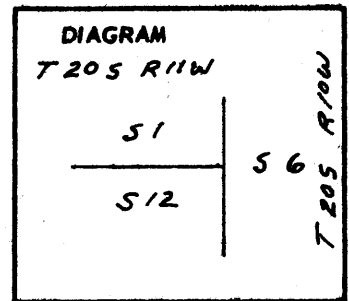


Description of monument and accessories I established to perpetuate the original location of this corner

From the original maple B.T. in NE quadrant I placed a 2" X 36" galvanized iron pipe, flanged at bottom and capped with a bronze disk welded on top. The monument projects 6" above ground. I filled in around the pipe monument with stone and packed earth.

Bearing Trees Set:

- a 24" fir bears N 30° W 75.29 feet
- an 18" fir bears S 3° W 23.93 feet

I stamped the disk →

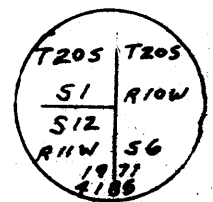

James W. Parkman

Office of COUNTY SURVEYOR County of Douglas
 State of OREGON, I hereby certify that the within instrument was filed in this office
 for record on the 29 day of JUNE, 1971, at 11 o'clock A.m., (signed)
James W. Parkman by _____ (DEPUTY)
 (COUNTY OFFICIAL)

#47- T20-10 ✓
 #100 T20-11W ✓
 Form R6-7100-57 (9/66)

CORNER #13 ON MAP

C.S File 55 / 201-16

Map File M 41 + 77