


CERTIFIED RECORD OF LAND CORNER MONUMENTATION

History of original corner establishment:

Corner established in 1892 by General Land Office

Contract Survey

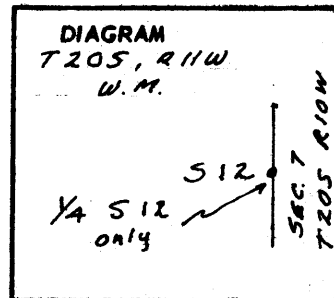

Original Survey record states: A willow 3 ins. dia. which I marked $\frac{1}{4}$ s on W. side for $\frac{1}{4}$ section corner, from Which:

- a willow 3 ins. dia. bears N 3° E 4 lks. dist., marked $\frac{1}{4}$ S B.T.
- a willow 3 ins. dia. bears S 5° W 10 lks. dist., marked $\frac{1}{4}$ S B.T.

1894 survey makes this corner common to Section 12 only


Description of corner evidence found:

None

Description of monument and accessories I established to perpetuate the original location of this corner

At the properly proportioned position I placed a 2" x 36" galvanized iron pipe, flanged at the bottom and capped with a bronze disk welded on top. The monument projects 6" above ground. I filled in around the pipe monument with stone and packed earth.

I stamped the disk

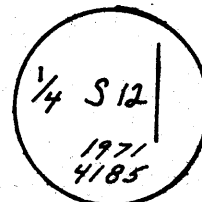

I established new bearing trees as follows. Each bearing tree has a scribed face and a U.S.F.S. bearing tree sign breast high and facing the monument.

Bearing trees set:

- a 32" fir bears S 66° W 33.90 feet
- a 20" fir bears N 73° W 29.10 feet

James W. [Signature]

Office of County Surveyor County of Douglas
 State of Oregon, I hereby certify that the within instrument was filed in this office
 for record on the 24 day of June, 1971, at 11 o'clock A.m., (signed)
[Signature] by _____
 (COUNTY OFFICIAL) (DEPUTY)

#49 - T20-10W ✓
 #102 T20-11W ✓
 Form R6-7100-57 (9/66)

CORNER #15 ON MAP

C.S. File 55 / 201-57

Map File M 41 T 77