


LL

BEARINGS BASED ON  
S 0° 03' E. PER C S M 18-34

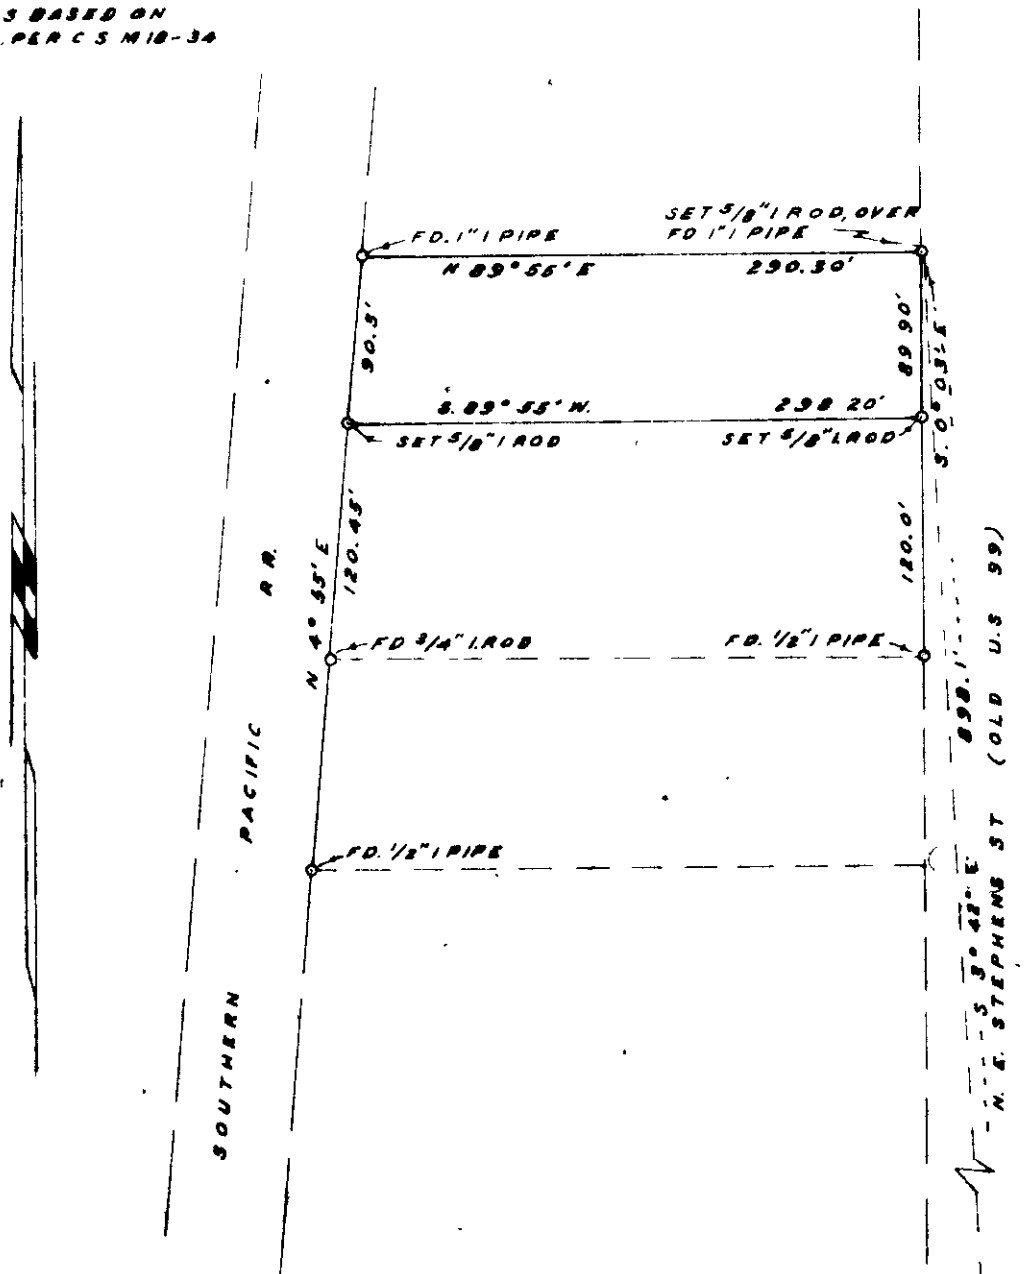

SURVEY TO SET PROR CORNERS  
 IN SECTION 12, T. 27 S., R. 6 W. W.M.  
 BY BAUGHMAN SURVEYING SERVICE  
 FOR ELDON HOWARD NOV. 1971

SCALE: 1"=100'

SW COR D.L.C 390

REGISTERED  
 SURVEYOR  
 OREGON  
 STATE OF OREGON  
 [Signature]  
 558

COUNTY SURVEYORS FILE DATA  
 DO NOT REMOVE FROM OFFICE

55/200