


CERTIFIED RECORD OF LAND CORNER MONUMENTATION

History of original corner establishment:

Never Set

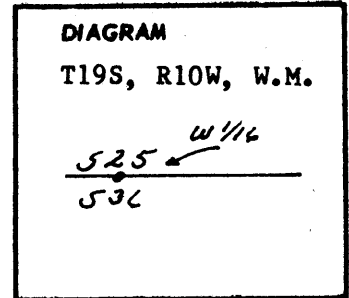


Description of corner evidence found:

None

Description of monument and accessories I established to perpetuate the original location of this corner

At the properly proportioned position I placed a 2" X 36" galvanized iron pipe, flanged at the bottom and capped with a bronze disk welded on top. The monument projects 6" above the ground. I filled in around the pipe monument with stone and packed earth.

I stamped the disk

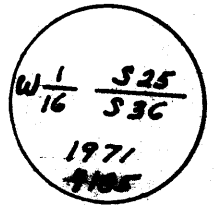

I established new bearing trees as follows. Each bearing tree has a scribed face and a U.S.F.S. bearing tree sign breast high and facing the monument.

Bearing trees set:

- a 36" D. Fir bears due North 20.4 feet
- a 20" hemlock bears S 17° E 14.27 feet

Office of County Surveyor County of Douglas
 State of Oregon , I hereby certify that the within instrument was filed in this office
 for record on the 4 day of AUGUST, 1971, at 2 o'clock P.M., (signed)
 James W. Patten by
 (COUNTY OFFICIAL) (DEPUTY)

James W. Patten