


CERTIFIED RECORD OF LAND CORNER MONUMENTATION

History of original corner establishment:

Corner established in 1895 by General Land Office
Resurveyed in 1899 - Contract Survey

Original Survey record states: The 1/4 sec. cor.
established in former survey (1895) which is a
chittem tree 6 ins. diam. marked 1/4S 35 on W. &
36 on E. sides. From which:

a vine maple 6 ins. diam. bears S 25° E 16 lks. dist. marked 1/4S B.T.
a fir 10' ins. diam. bears S 83° W 16 lks. dist. Marked 1/4S B.T.

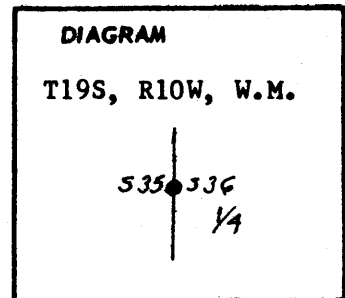


Description of corner evidence found:

none

Description of monument and accessories I established to perpetuate the
original location of this corner

At the properly proportioned distance I placed a 2" X 36" galvanized iron
pipe, flanged at the bottom and capped with a bronze disk welded on the
top. The monument projects 6" above the ground. I filled in around the
pipe monument with stone and packed earth.

I stamped the disk

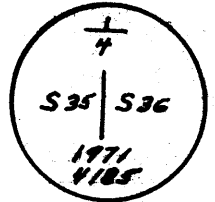

I established new bearing trees as follows. Each bearing tree has a
scribed face and a U.S.F.S. bearing tree sign breast high and facing
the monument.

Bearing trees set:

- a 20" D. Fir bears N 54° W 27.5 feet
- a 46" D. Fir bears S 39° E 12.0 feet

Office of County Surveyor County of Douglas
Oregon
State of Oregon, I hereby certify that the within instrument was filed in this office
for record on the 4 day of AUGUST, 1971, at 2 o'clock P.m., (signed)
James W. [Signature] by (DEPUTY)
(COUNTY OFFICIAL)

James W. [Signature]