


CERTIFIED RECORD OF LAND CORNER MONUMENTATION

History of original corner establishment:

Corner established in 1895 by General Land Office  
Resurveyed in 1899 - Contract Survey

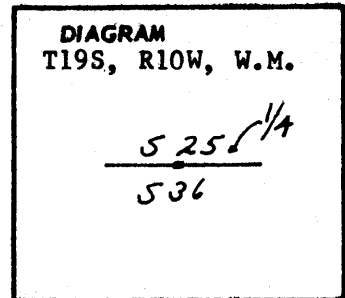

Original Survey record states: Set a fir post 3 ft. long, 3 ins. sq., 24 ins. in the ground for 1/4 sec. cor. Marked 1/4 S25 on N. and 36 on S. faces: from which  
A fir 7 ins. diam. bears N 11° E 11 lks. dist. Marked 1/4S B.T.  
A fir 8 ins. diam. bears S 10° E 17 lks. dist. Marked 1/4S B.T.  
Old corner bears N 2 lks. dist. I destroy it. ( corner set in 1895 )


Description of corner evidence found:

None

Description of monument and accessories I established to perpetuate the original location of this corner

At the properly proportioned position I placed a 2" X 36" galvanized iron pipe, flanged at the bottom and capped with a bronze disk welded on top. The monument projects 6" above ground. I filled in around the pipe monument with stone and packed earth.

I stamped the disk

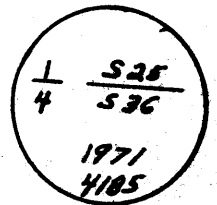

I established new bearing trees as follows. Each bearing tree has a scribed face and a U.S.F.S. bearing tree sign breast high and facing the monument.

Bearing trees set:

- a 32" D. Fir bears N 10° E 50.3 feet
- a 28" D. Fir bears S 60° E 29.27 feet

Office of ... County Surveyor ..... County of ... Douglas .....  
 State of ... Oregon ..... , I hereby certify that the within instrument was filed in this office  
 for record on the ... day of ... AUGUST ..... 1971, at ... 2 o'clock ... P.m., (signed)  
 \_\_\_\_\_ by \_\_\_\_\_  
 (COUNTY OFFICIAL) (DEPUTY)

*James W. Pink*