


CERTIFIED RECORD OF LAND CORNER MONUMENTATION

History of original corner establishment:

Corner established in 1895 by General Land Office.  
Resurveyed in 1899 - Contract Survey

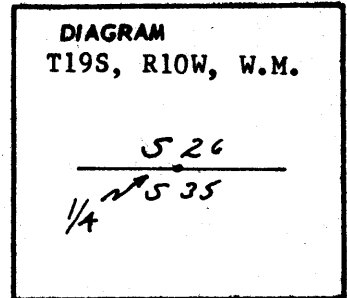

Original Survey record states: Corner is a fir tree 7" diameter, marked 1/4S26 on N. & 35 on S. side from which:

- A fir 8 ins. diam. bears N 64° W 34 lks. dist. Marked 1/4S B.T.
- A fir 18 ins. diam. bears S 21° E 59 lks. dist. Marked 1/4S B.T.


Description of corner evidence found:

Found a faint X and original line blazes. Found a 32" fir with overgrown face - opened face and found original scribing. This is the formerly 18" fir in the Southeast quadrant.

Description of monument and accessories I established to perpetuate the original location of this corner

At the proper distance and bearing from the original B.T., I placed a 2" X 36" galvanized iron pipe, flanged at the bottom and capped with a bronze disk welded on top. The monument projects 6" above ground. I filled in around the pipe monument with stone and packed earth.

I stamped the disk

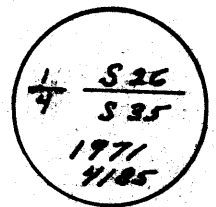

I established new bearing trees as follows. Each bearing tree has a scribed face and a U.S.F.S. bearing tree sign breast high and facing the monument.

Bearing trees set:

- a 24" D. fir bears S 19° W 51.0 feet
- a 36" D. fir bears N 25° E 41.75 feet

Office of .....County..Surveyor..... County of.....Douglas.....  
State of Oregon....., I hereby certify that the within instrument was filed in this office  
for record on the 4 day of AUGUST, 1971, at 2 o'clock P.M., (signed)

*James W. Palmer*  
(COUNTY OFFICIAL) (DEPUTY)